

ELEVATION CERTIFICATE

Important: Read the instructions on pages 1 - 7.

SECTION A - PROPERTY OWNER INFORMATION

BUILDING OWNER'S NAME <i>Cory Burk</i>		For Insurance Company Use: Policy Number
BUILDING STREET ADDRESS (Including Apt., Unit, Suite, and/or Bldg. No.) OR P.O. ROUTE AND BOX NO. <i>10530 N Poquitos Valley Rd</i>		Company NAIC Number
CITY	STATE	ZIP CODE

PROPERTY DESCRIPTION (Lot and Block Numbers, Tax Parcel Number, Legal Description, etc.)

APN 103-01-202A

BUILDING USE (e.g., Residential, Non-residential, Addition, Accessory, etc. Use Comments area if necessary.)

Residential

LATITUDE/LONGITUDE (OPTIONAL) (##° - ##' - ##.###" or ##.#####") HORIZONTAL DATUM: NAD 1927 NAD 1983 SOURCE: GPS (Type): USGS Quad Map Other:

SECTION B - FLOOD INSURANCE RATE MAP (FIRM) INFORMATION

B1. NFIP COMMUNITY NAME & COMMUNITY NUMBER <i>Yavapai County 040093</i>		B2. COUNTY NAME <i>Yavapai</i>		B3. STATE <i>AZ</i>	
B4. MAP AND PANEL NUMBER <i>04015C175D</i>	B5. SUFFIX <i>F</i>	B6. FIRM INDEX DATE <i>6-6-01</i>	B7. FIRM PANEL EFFECTIVE/REVISED DATE <i>6-6-01</i>	B8. FLOOD ZONES <i>A</i>	B9. BASE FLOOD ELEVATION(S) <i>101.38'</i>

B10. Indicate the source of the Base Flood Elevation (BFE) data or base flood depth entered in B9.

FIS Profile FIRM Community Determined Other (Describe):

B11. Indicate the elevation datum used for the BFE in B9: NGVD 1929 NAVD 1988 Other (Describe):

B12. Is the building located in a Coastal Barrier Resources System (CBRS) area or Otherwise Protected Area (OPA)? Yes No
Designation Date:

SECTION C - BUILDING ELEVATION INFORMATION (SURVEY REQUIRED)


C1. Building elevations are based on: Construction Drawings* Building Under Construction* Finished Construction
*A new Elevation Certificate will be required when construction of the building is complete.

C2. Building Diagram Number *5* (Select the building diagram most similar to the building for which this certificate is being completed - see pages 6 and 7. If no diagram accurately represents the building, provide a sketch or photograph.)

C3. Elevations - Zones A1-A30, AE, AH, A (with BFE), VE, V1-V30, V (with BFE), AR, AR/A, AR/AE, AR/A1-A30, AR/AH, AR/AO
Complete Items C3.a-i below according to the building diagram specified in Item C2. State the datum used. If the datum is different from the datum used for the BFE in Section B, convert the datum to that used for the BFE. Show field measurements and datum conversion calculation. Use the space provided or the Comments area of Section D or Section G, as appropriate, to document the datum conversion.
Datum _____ Conversion/Comments _____
Elevation reference mark used _____ Does the elevation reference mark used appear on the FIRM? Yes No

- a) Top of bottom floor (including basement or enclosure) *103.88* ft.(m)
- b) Top of next higher floor *NA* ft.(m)
- c) Bottom of lowest horizontal structural member (V zones only) *102.38* ft.(m)
- d) Attached garage (top of slab) *NA* ft.(m)
- e) Lowest elevation of machinery and/or equipment servicing the building (Describe in a Comments area.) *NA* ft.(m)
- f) Lowest adjacent (finished) grade (LAG) *100.8* ft.(m)
- g) Highest adjacent (finished) grade (HAG) *101.0* ft.(m)
- h) No. of permanent openings (flood vents) within 1 ft. above adjacent grade *NA*
- i) Total area of all permanent openings (flood vents) in C3.h *NA* sq. in. (sq. cm)

License Number, Embossed Seal, Signature, and Date

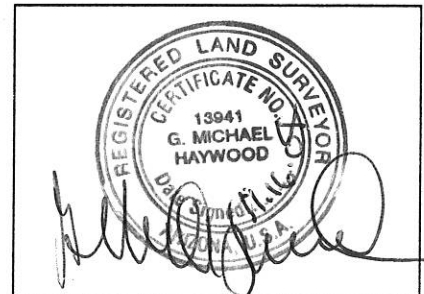

SECTION D - SURVEYOR, ENGINEER, OR ARCHITECT CERTIFICATION

This certification is to be signed and sealed by a land surveyor, engineer, or architect authorized by law to certify elevation information. I certify that the information in Sections A, B, and C on this certificate represents my best efforts to interpret the data available. I understand that any false statement may be punishable by fine or imprisonment under 18 U.S. Code, Section 1001.

CERTIFIER'S NAME <i>G. Michael Haywood</i>		LICENSE NUMBER <i>AZ R.L.S. 13941</i>	
TITLE <i>PRES.</i>	COMPANY NAME <i>M. HAYWOOD ASSOC. INC.</i>		
ADDRESS <i>115 E Goodwin</i>	CITY <i>PRESCOTT</i>	STATE <i>AZ</i>	ZIP CODE <i>86301</i>
SIGNATURE <i>[Signature]</i>	DATE <i>11-16-04</i>	TELEPHONE <i>928-778-5101</i>	

