U.S. DEPARTMENT OF HOMELAND SECURITY

ELEVATION CERTIFICATE


OMB No. 1660-0008	
Expires February 28.	2009

Federal Emergency Management Agency National Flood Insurance Program

.nportant: Read the instructions on pages . ..

SECTION A - PROPERTY INFORMATION	For Insurance Company Use:						
A1. Building Owner's Name Charles & Nicole McNally	Policy Number						
A2. Building Street Address (including Apt., Unit, Suite, and/or Bldg. No.) or P.O. Route and Box No. 9245 N. Charity Court	Company NAIC Number						
City PresonValley State AZ ZIP Code8 86314							
A3. Property Description (Lot and Block Numbers, Tax Parcel Number, Legal Description, etc.) Tax Parcel No. 103-01-221J							
A4. Building Use (e.g., Residential, Non-Residential, Addition, Accessory, etc.) Manufactured Home On Lock Stendal. A5. Latitude/Longitude: Lat. 340 401 26 mg. 120 191 32 8 Horizontal Datum: NAD 1927 NAD 1983 A6. Attach at least 2 photographs of the building if the Certificate is being used to obtain flood insurance. A7. Building Diagram Number 8 A8. For a building with a crawl space or enclosure(s), provide a) Square footage of crawl space or enclosure(s) b) No. of permanent flood openings in the crawl space or enclosure(s) walls within 1.0 foot above adjacent grade c) Total net area of flood openings in A8.b sq in A9. For a building with an attached garage, provide: a) Square footage of attached garage sq ft b) No. of permanent flood openings in the attached garage walls within 1.0 foot above adjacent grade c) Total net area of flood openings in A9.b sq in							
SECTION B - FLOOD INSURANCE RATE MAP (FIRM) INFORMATION							
	3. State rizona						
B4. Map/Panel Number B5. Suffix B6. FIRM Index Date B7. FIRM Panel Effective/Revised Date B8. Flood Zone(s) 04025C1750 F 6/6/01 6/6/01 A	B9. Base Flood Elevation(s) (Zone AO, use base flood depth) 4865.0						
10. Indicate the source of the Base Flood Elevation (BFE) data or base flood depth entered in Item B9.	4000.0						
☐ FIS Profile ☐ FIRM ☐ Community Determined ☐ Other (Describe) WRG Flood Study 311. Indicate elevation datum used for BFE in Item B9: ☐ NGVD 1929 ☐ NAVD 1988 ☐ Other (Describe) 312. Is the building located in a Coastal Barrier Resources System (CBRS) area or Otherwise Protected Area (OPA)? ☐ Yes ☐ NO Designation Date ☐ CBRS ☐ OPA							
SECTION C - BUILDING ELEVATION INFORMATION (SURVEY REQUIRED	0)						
E1. Building elevations are based on: Construction Drawings* Building Under Construction* Finished Construction *A new Elevation Certificate will be required when construction of the building is complete. E1. Elevations – Zones A1-A30, AE, AH, A (with BFE), VE, V1-V30, V (with BFE), AR, AR/A, AR/AE, AR/A1-A30, AR/AH, AR/AO. Complete Items C2.a-g below according to the building diagram specified in Item A7. Benchmark Utilized Vertical Datum NOVI 1929 Conversion/Comments 100 ERMS: 3"BC at SE con Section 14							
Check the measurement used.							
b) Top of the next higher floor c) Bottom of the lowest horizontal structural member (V Zones only) d) Attached garage (top of slab) e) Lowest elevation of machinery or equipment servicing the building (Describe type of equipment in Comments) f) Lowest adjacent (finished) grade (LAG) MA	(Puerto Rico only) (Puerto Rico only) Rico only) (Puerto Rico only)						
This certification is to be signed and sealed by a land surveyor, engineer, or architect authorized by law to certify elevation nformation. I certify that the information on this Certificate represents my best efforts to interpret the data available. I understand that any false statement may be punishable by fine or imprisonment under 18 U.S. Code, Section 1001. Check here if comments are provided on back of form. 3386	SERTIFICATE NO PO						
Registered Land Surveyor RST Land Surveying Inc. Company Name 3720 N. Robert Rd. Ste 2 Prescott Valley AZ 86314	THOMAS A. LIUZZO						
3720 N. Robert Kd. Ste 2 Prescott Valley AZ 86314 Address City State ZIP Code	Soned						

IMPORTANT: In these spaces	The second secon			For	r Insurance Company Use:
Building Street Address (including Ap 9245 N. Charify	ot., Unit, Su nd/or Bldg. No.)	or P.O. Route and	Box No.	Pol	licy Number
City State ZIP Code Prescott Valley	12 86312				mpany NAIC Number
/ SECTIO	N D - SURVEYOR, ENGINE	ER, OR ARCHI	TECT CERTIFICATION	(CONTINU	JED)
Copy both sides of this Elevation Cer	rtificate for (1) community official	, (2) insurance age	ent/company, and (3) build	ling owner.	
Comments AMA C.Ze	equipment is	A/C Uni	+		
	0 0	7			
de	1		7 (7 - 2 - 1 - 1 - 1 - 1 - 1 - 1 - 1 - 1 - 1		
Signature	11	Date	7-26-07		Check here if attachments
SECTION E-BUILDING ELI	EXATION INFORMATION (S	URVEY NOT R	EQUIRED) FOR ZONE	AO AND Z	ONE A (WITHOUT BFE)
 b) Top of bottom floor (including E2. For Building Diagrams 6-8 with (elevation C2.b in the diagrams E3. Attached garage (top of slab) is E4. Top of platform of machinery ar E5. Zone AO only: If no flood depti 	I grade, if available. Check the nor the following and check the application of the following and check the application of the following passement, crawl space, or encompermanent flood openings provings of the building is	neasurement used propriate boxes to losure) is ded in Section A It feet me meters above ilding is of the bottom floor	I. In Puerto Rico only, ento show whether the elevation of the show whether the elevation of the show whether the elevation of the show the HAG.	er meters. on is above or ors above ors above ors above ors HAG. above or	or below the highest adjacent or below the HAG. or below the LAG. tions), the next higher floor below the HAG.
SECTIO	N F - PROPERTY OWNER (OR OWNER'S F	REPRESENTATIVE) C	ERTIFICAT	CION
The property owner or owner's author					
or Zone AO must sign here. The stat	ements in Sections A, B, and E a	are correct to the b	est of my knowledge.		
Property Owner's or Owner's Authorize	Box ///	Dewes	, /4	2	86327
Address		City /	St	ate	ZIP Code
Signature		Date	Тє	elephone	
Comments	The state of the s				
			7		
	SECTION G - COMM	ILINITY INFORM	MATION (ORTIONAL)		Check here if attachments
he local official who is authorized by la				ance can cor	mplete Sections A. B. C. (or E)
and G of this Elevation Certificate. Con	nplete the applicable item(s) and	sign below. Chec	ck the measurement used	in Items G8.	and G9.
51. The information in Section C is authorized by law to certify	was taken from other documental elevation information. (Indicate	ation that has beer the source and da	n signed and sealed by a li te of the elevation data in	icensed surv the Commer	eyor, engineer, or architect who nts area below.)
	ed Section E for a building locate			munity-issue	ed BFE) or Zone AO.
	ms G4G9.) is provided for comi	munity floodplain r	nanagement purposes.		
G4. Permit Number	G5. Date Permit Issued		G6. Date Certificate Of	Compliance	/Occupancy Issued
67. This permit has been issued for:	☐ New Construction [☐ Substantial Imp	provement		
88. Elevation of as-built lowest floor (in	cluding basement) of the building	g:	feet meters (PR) Da	atum	
69. BFE or (in Zone AO) depth of flood	ing at the building site:	[feet meters (PR) Da	atum	
Local Official's Name					
Community Name	Post-it® Fax Note 767		-08 pages▶	*	
Signature	TO ANNE MARIE	From D8	B	¥.	
Comments	Co./Dept. AM. FAMily.	INS Co. VC	1700		
	Phone #	Phone # >	71-3197	*	
	Fax# 775-0193	Fax # 7	71-3427		
******	·				☐ Check here if attachments

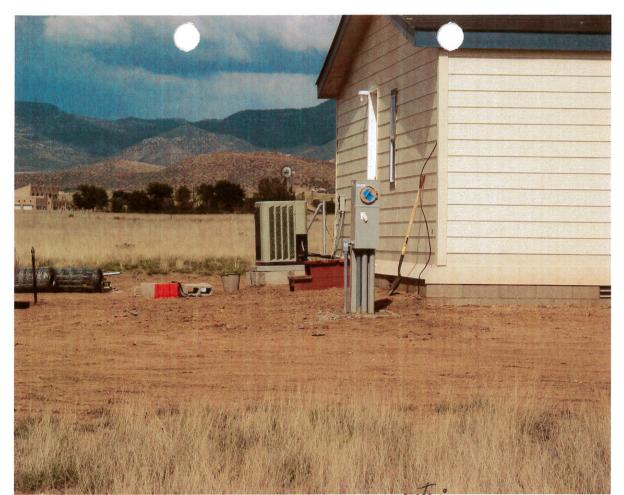

Site Visit 7-31-07 elec + Ac raised as requisted



final guen

9245 1. Charity Court



Front



Seft



Rear



Right