

ELEVATION CERTIFICATE

Important: Read the instructions on pages 1 - 7.

SECTION A - PROPERTY OWNER INFORMATION

BUILDING OWNER'S NAME <i>JOHN AND CAROL CRENSHAW</i>		For Insurance Company Use: Policy Number	
BUILDING STREET ADDRESS (Including Apt., Unit, Suite, and/or Bldg. No.) OR P.O. ROUTE AND BOX NO. <i>AT40 ECHO CANYON PLACE</i>		Company NAIC Number	
CITY <i>PRESCOTT</i>	STATE <i>AZ</i>	ZIP CODE <i>86305</i>	
PROPERTY DESCRIPTION (Lot and Block Numbers, Tax Parcel Number, Legal Description, etc.) <i>APN 106-10-152 Q</i>			
BUILDING USE (e.g., Residential, Non-residential, Addition, Accessory, etc. Use Comments area if necessary.) <i>RESIDENTIAL</i>			
LATITUDE/LONGITUDE (OPTIONAL) (## - ## - ##.##" or ##.#####")		HORIZONTAL DATUM: <input type="checkbox"/> NAD 1927 <input type="checkbox"/> NAD 1983	
		SOURCE: <input type="checkbox"/> GPS (Type): <input type="checkbox"/> USGS Quad Map <input type="checkbox"/> Other:	

SECTION B - FLOOD INSURANCE RATE MAP (FIRM) INFORMATION

B1. NFIP COMMUNITY NAME & COMMUNITY NUMBER <i>YAVAPAI COUNTY 040093</i>		B2. COUNTY NAME <i>YAVAPAI</i>		B3. STATE <i>AZ</i>	
B4. MAP AND PANEL NUMBER <i>04025C 2085</i>	B5. SUFFIX <i>F</i>	B6. FIRM INDEX DATE <i>6-6-01</i>	B7. FIRM PANEL EFFECTIVE/REVISED DATE <i>6-6-01</i>	B8. FLOOD ZONES <i>UNSHADED</i> <input checked="" type="checkbox"/>	B9. BASE FLOOD ELEVATION(S)
B10. Indicate the source of the Base Flood Elevation (BFE) data or base flood depth entered in B9. <input type="checkbox"/> FIS Profile <input type="checkbox"/> FIRM <input checked="" type="checkbox"/> Community Determined <input checked="" type="checkbox"/> Other (Describe): <i>MIN FFE = 5035.3'</i>					
B11. Indicate the elevation datum used for the BFE in B9: <input type="checkbox"/> NGVD 1929 <input type="checkbox"/> NAVD 1988 <input checked="" type="checkbox"/> Other (Describe): <i>LOCAL RM</i>					
B12. Is the building located in a Coastal Barrier Resources System (CBRS) area or Otherwise Protected Area (OPA)? <input type="checkbox"/> Yes <input checked="" type="checkbox"/> No Designation Date: _____					


SECTION C - BUILDING ELEVATION INFORMATION (SURVEY REQUIRED)

C1. Building elevations are based on: Construction Drawings* Building Under Construction* Finished Construction
 *A new Elevation Certificate will be required when construction of the building is complete.

C2. Building Diagram Number *8* (Select the building diagram most similar to the building for which this certificate is being completed - see pages 6 and 7. If no diagram accurately represents the building, provide a sketch or photograph.)

C3. Elevations - Zones A1-A30, AE, AH, A (with BFE), VE, V1-V30, V (with BFE), AR, AR/A, AR/AE, AR/A1-A30, AR/AH, AR/AO
 Complete Items C3.a-i below according to the building diagram specified in Item C2. State the datum used. If the datum is different from the datum used for the BFE in Section B, convert the datum to that used for the BFE. Show field measurements and datum conversion calculation. Use the space provided or the Comments area of Section D or Section G, as appropriate, to document the datum conversion.
 Datum *LOCAL RM* Conversion/Comments *BASED ON WILLOW LAKE OVEFLOW*
 Elevation reference mark used _____ Does the elevation reference mark used appear on the FIRM? Yes No

<input type="checkbox"/> a) Top of bottom floor (including basement or enclosure)	<u><i>N/A</i></u>	ft. (m)
<input type="checkbox"/> b) Top of next higher floor	<u><i>N/A</i></u>	ft. (m)
<input type="checkbox"/> c) Bottom of lowest horizontal structural member (V zones only)	<u><i>N/A</i></u>	ft. (m)
<input type="checkbox"/> d) Attached garage (top of slab)	<u><i>N/A</i></u>	ft. (m)
<input type="checkbox"/> e) Lowest elevation of machinery and/or equipment servicing the building (Describe in a Comments area.)	<u><i>N/A</i></u>	ft. (m)
<input type="checkbox"/> f) Lowest adjacent (finished) grade (LAG)	<u><i>N/A</i></u>	ft. (m)
<input type="checkbox"/> g) Highest adjacent (finished) grade (HAG)	<u><i>N/A</i></u>	ft. (m)
<input type="checkbox"/> h) No. of permanent openings (flood vents) within 1 ft. above adjacent grade	<u><i>N/A</i></u>	
<input type="checkbox"/> i) Total area of all permanent openings (flood vents) in C3.h	<u><i>N/A</i></u>	sq. in. (sq. cm)

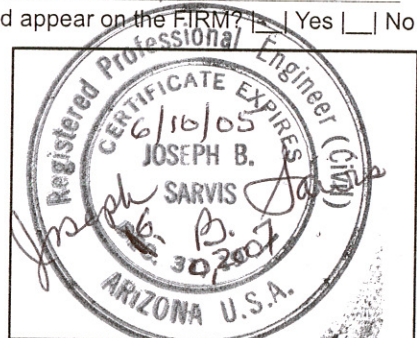

SECTION D - SURVEYOR, ENGINEER, OR ARCHITECT CERTIFICATION

This certification is to be signed and sealed by a land surveyor, engineer, or architect authorized by law to certify elevation information. I certify that the information in Sections A, B, and C on this certificate represents my best efforts to interpret the data available. I understand that any false statement may be punishable by fine or imprisonment under 18 U.S. Code, Section 1001.

CERTIFIER'S NAME <i>JOSEPH B. SARVIS</i>		LICENSE NUMBER <i>RLS 15904</i>	
TITLE		COMPANY NAME	
ADDRESS <i>527 ELLENWOOD DRIVE</i>	CITY <i>PRESCOTT</i>	STATE <i>AZ</i>	ZIP CODE <i>86303</i>
SIGNATURE <i>Joseph B. Sarvis</i>		DATE	TELEPHONE <i>928-445-2153</i>

IMPORTANT: In these spaces, copy the corresponding information from Section A.		For Insurance Company Use:
BUILDING STREET ADDRESS (Including Apt., Unit, Suite, and/or Bldg. No.) OR P.O. ROUTE AND BOX NO. 1740 ECHO CANYON PLACE		Policy Number
CITY PRESCOTT	STATE AZ	ZIP CODE 86305
		Company NAIC Number

SECTION D - SURVEYOR, ENGINEER, OR ARCHITECT CERTIFICATION (CONTINUED)

Copy both sides of this Elevation Certificate for (1) community official, (2) insurance agent/company, and (3) building owner.

COMMENTS

TOP OF BOTTOM FLOOR (12'x12' SLAB FOR STORAGE) = 5037.23'

TOP OF NEXT HIGHER FLOOR = 5047.23'; ATTACHED GARAGE = 5045.25' LOWEST ELEV. OF MACHINERY = 5040.27' LOWEST ADJACENT FINISH GRADE = 5035.67'

HIGHEST ADJACENT FINISH GRADE = 5046.60' NO VENTS WITHIN 12" OF GRADE Check here if attachments

SECTION E - BUILDING ELEVATION INFORMATION (SURVEY NOT REQUIRED) FOR ZONE AO AND ZONE A (WITHOUT BFE)

For Zone AO and Zone A (without BFE), complete Items E1. through E4. If the Elevation Certificate is intended for use as supporting information for a LOMA or LOMR-F, Section C must be completed.

- E1. Building Diagram Number _____ (Select the building diagram most similar to the building for which this certificate is being completed - see pages 6 and 7. If no diagram accurately represents the building, provide a sketch or photograph.)
- E2. The top of the bottom floor (including basement or enclosure) of the building is ft.(m) in.(cm) above or below (check one) the highest adjacent grade. (Use natural grade, if available.)
- E3. For Building Diagrams 6-8 with openings (see page 7), the next higher floor or elevated floor (elevation b) of the building is ft.(m) in.(cm) above the highest adjacent grade.
- E4. The top of the platform of machinery and/or equipment servicing the building is ft. (m) in. (cm) above or below (check one) the highest adjacent grade. (Use natural grade, if available.)
- E5. For Zone AO only: If no flood depth number is available, is the top of the bottom floor elevated in accordance with the community's floodplain management ordinance? Yes No Unknown. The local official must certify this information in Section G.

SECTION F - PROPERTY OWNER (OR OWNER'S REPRESENTATIVE) CERTIFICATION

The property owner or owner's authorized representative who completes Sections A, B, C (Items C3.h and C3.i only), and E for Zone A (without a FEMA-issued or community-issued BFE) or Zone AO must sign here. The statements in Sections A, B, C, and E are correct to the best of my knowledge.

PROPERTY OWNER'S OR OWNER'S AUTHORIZED REPRESENTATIVE'S NAME _____

ADDRESS _____ CITY _____ STATE _____ ZIP CODE _____

SIGNATURE _____ DATE _____ TELEPHONE _____

COMMENTS _____

Check here if attachments

SECTION G - COMMUNITY INFORMATION (OPTIONAL)

The local official who is authorized by law or ordinance to administer the community's floodplain management ordinance can complete Sections A, B, C (or E), and G of this Elevation Certificate. Complete the applicable item(s) and sign below.

- G1. The information in Section C was taken from other documentation that has been signed and embossed by a licensed surveyor, engineer, or architect who is authorized by state or local law to certify elevation information. (Indicate the source and date of the elevation data in the Comments area below.)
- G2. A community official completed Section E for a building located in Zone A (without a FEMA-issued or community-issued BFE) or Zone AO.
- G3. The following information (Items G4-G9) is provided for community floodplain management purposes.

G4. PERMIT NUMBER	G5. DATE PERMIT ISSUED	G6. DATE CERTIFICATE OF COMPLIANCE/OCCUPANCY ISSUED
-------------------	------------------------	---

G7. This permit has been issued for: New Construction Substantial Improvement

G8. Elevation of as-built lowest floor (including basement) of the building is: _____ . _____ ft.(m) Datum: _____

G9. BFE or (in Zone AO) depth of flooding at the building site is: _____ . _____ ft.(m) Datum: _____

LOCAL OFFICIAL'S NAME _____ TITLE _____

COMMUNITY NAME _____ TELEPHONE _____

SIGNATURE _____ DATE _____

COMMENTS _____

Check here if attachments

ELEVATION OF FLOODPLAIN PROPERTY

When Completed Return To: YAVAPAI COUNTY DEVELOPMENT SERVICES – FLOODPLAIN UNIT

500 S. Marina St., Prescott, AZ, 86303 (928) 771-3197 FAX (928) 771-3427 Office: Prescott _____
10 S. 6th St., Cottonwood, AZ 86326 (928) 639-8151 FAX (928) 639-8118 Cottonwood _____

DATE JUNE 6, 2005

ASSESSOR'S PARCEL NUMBER 106-10-152 Q

SUBDIVISION NAME UNIT/PHASE AND LOT NUMBER _____

OWNER JAY & CAROL CRENSHAW

SITUS ADDRESS 4740 ECHO CANYON PLACE

BASE BENCHMARK: Number US89-09 Elevation 5048.91


PROPERTY BENCHMARK 5061.75

DESCRIPTION OF PROPERTY BENCHMARK PK NAIL IN GRANITE


GROUND ELEVATIONS AT BUILDING SITE ① 5035.67 ② 5046.60 ③ 5041.20
(Please provide a minimum of three (3) elevation points, representative of the site)

Sketch of Lot
(include location of property benchmark and the elevations)

Remarks _____

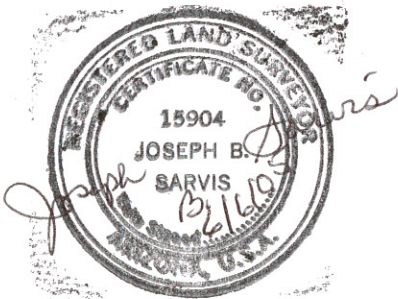

(Seal)

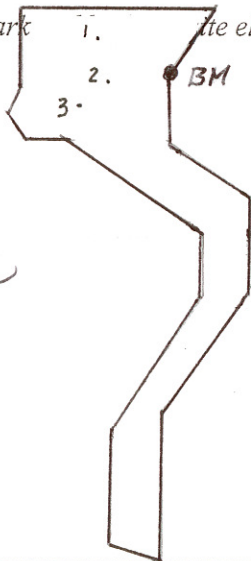

Signed Joseph B. Sarvis
N/A
Company Name _____
Address 527 Ellenwood Dr.
Prescott, Az. 86303
Telephone 445-2153

FOR YAVAPAI COUNTY FLOOD CONTROL DISTRICT USE:

Date: _____

Base Flood Elevation + 1.0' = Regulatory Elevation

* ELEVATION DETERMINATIONS ARE BASED ON BEST AVAILABLE DATA WHEN CALCULATED. ELEVATIONS ARE SUBJECT TO CHANGE WHEN NEW OR REVISED FLOOD STUDIES OR DATA IS SUPPLIED TO THE DISTRICT.