

# ELEVATION CERTIFICATE

Important: Read the instructions on pages 1 - 7.

<b>SECTION A - PROPERTY OWNER INFORMATION</b>			For Insurance Company Use:
BUILDING OWNER'S NAME Travis Applebee		Policy Number	
BUILDING STREET ADDRESS (Including Apt., Unit, Suite, and/or Bldg. No.) OR P.O. ROUTE AND BOX NO. 25050 N. Larita Road, P.O. Box 1686, Chino Valley		Company NAIC Number	
CITY Paulden	STATE AZ	ZIP CODE 86334	
PROPERTY DESCRIPTION (Lot and Block Numbers, Tax Parcel Number, Legal Description, etc.) APN 304-01-095T			
BUILDING USE (e.g., Residential, Non-residential, Addition, Accessory, etc. Use a Comments area, if necessary.) Residential			
LATITUDE/LONGITUDE (OPTIONAL) ( ##° - ##' - ##.###" or ###.####°)	HORIZONTAL DATUM: <input type="checkbox"/> NAD 1927 <input type="checkbox"/> NAD 1983	SOURCE: <input type="checkbox"/> GPS (Type): _____ <input type="checkbox"/> USGS Quad Map <input type="checkbox"/> Other: _____	

## SECTION B - FLOOD INSURANCE RATE MAP (FIRM) INFORMATION

B1. NFIP COMMUNITY NAME & COMMUNITY NUMBER Yavapai County, Arizona		B2. COUNTY NAME Yavapai		B3. STATE AZ	
B4. MAP AND PANEL NUMBER 040093-0585	B5. SUFFIX D	B6. FIRM INDEX DATE 03/09/99	B7. FIRM PANEL EFFECTIVE/REVISED DATE 01/26/00	B8. FLOOD ZONE(S) AE	B9. BASE FLOOD ELEVATION(S) (Zone AO, use depth of flooding) 4384.0

B10. Indicate the source of the Base Flood Elevation (BFE) data or base flood depth entered in B9.  
 FIS Profile     FIRM     Community Determined     Other (Describe): \_\_\_\_\_

B11. Indicate the elevation datum used for the BFE in B9:  NGVD 1929     NAVD 1988     Other (Describe): \_\_\_\_\_

B12. Is the building located in a Coastal Barrier Resources System (CBRS) area or Otherwise Protected Area (OPA)?  Yes  No Designation Date \_\_\_\_\_

## SECTION C - BUILDING ELEVATION INFORMATION (SURVEY REQUIRED)

C1. Building elevations are based on:  Construction Drawings\*     Building Under Construction\*     Finished Construction

\*A new Elevation Certificate will be required when construction of the building is complete.

C2. Building Diagram Number 5 (Select the building diagram most similar to the building for which this certificate is being completed - see pages 6 and 7. If no diagram accurately represents the building, provide a sketch or photograph.)

C3. Elevations - Zones A1-A30, AE, AH, A (with BFE), VE, V1-V30, V (with BFE), AR, AR/A, AR/AE, AR/A1-A30, AR/AH, AR/AO  
 Complete Items C3.-a-i below according to the building diagram specified in Item C2. State the datum used. If the datum is different from the datum used for the BFE in Section B, convert the datum to that used for the BFE. Show field measurements and datum conversion calculation. Use the space provided or the Comments area of Section D or Section G, as appropriate, to document the datum conversion.  
 Datum NGVD 1929 Conversion/Comments \_\_\_\_\_

Elevation reference mark used RM 50-2 Does the elevation reference mark used appear on the FIRM?  Yes  No

a) Top of bottom floor (including basement or enclosure)    4387.5 ft.(m)

b) Top of next higher floor    NA . \_\_\_\_ft.(m)

c) Bottom of lowest horizontal structural member (V zones only)    NA . \_\_\_\_ft.(m)

d) Attached garage (top of slab)    NA . \_\_\_\_ft.(m)

e) Lowest elevation of machinery and/or equipment servicing the building (Describe in a Comments area)    NA . \_\_\_\_ft.(m)


f) Lowest adjacent (finished) grade (LAG)    4384.7 ft.(m)

g) Highest adjacent (finished) grade (HAG)    4386.8 ft.(m)

h) No. of permanent openings (flood vents) within 1 ft. above adjacent grade NA

i) Total area of all permanent openings (flood vents) in C3.h NA sq. in. (sq. cm)

License Number, Embossed Seal, Signature, and Date

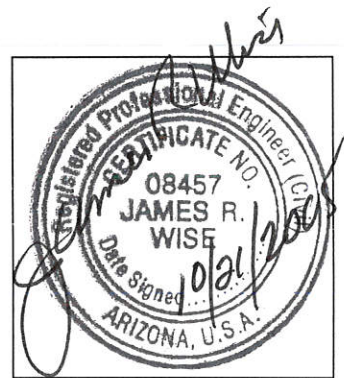

## SECTION D - SURVEYOR, ENGINEER, OR ARCHITECT CERTIFICATION

This certification is to be signed and sealed by a land surveyor, engineer, or architect authorized by law to certify elevation information.  
 I certify that the information in Sections A, B, and C on this certificate represents my best efforts to interpret the data available.  
 I understand that any false statement may be punishable by fine or imprisonment under 18 U.S. Code, Section 1001.

CERTIFIER'S NAME    James R. Wise    LICENSE NUMBER    AZ PE 8457

TITLE    Principal    COMPANY NAME    KelleyWise Engineering, Inc.

ADDRESS    146 Grove Avenue    CITY    Prescott    STATE    AZ    ZIP CODE    86301

SIGNATURE    *James R. Wise*    DATE    10/21/05    TELEPHONE    928-771-1730

Check here if attachments

COMMENTS

SIGNATURE

DATE

COMMUNITY NAME

TELEPHONE

LOCAL OFFICIAL'S NAME

TITLE

G7. This permit has been issued for:  New Construction  Substantial Improvement  
G8. Elevation of as-built lowest floor (including basement) of the building is: \_\_\_\_\_ ft.(m)  
G9. BFE or (in Zone AO) depth of flooding at the building site is: \_\_\_\_\_ ft.(m)  
Datum: \_\_\_\_\_ Datum: \_\_\_\_\_

G4. PERMIT NUMBER	G5. DATE PERMIT ISSUED	G6. DATE CERTIFICATE OF COMPLIANCE/OCCUPANCY ISSUED
-------------------	------------------------	---

G1.  The information in Section C was taken from other documentation that has been signed and embossed by a licensed surveyor, engineer, or architect who is authorized by state Certificate. Complete the applicable item(s) and sign below.  
G2.  A community official completed Section E for a building located in Zone A (without a FEMA-issued or community-issued BFE) or Zone AO.  
G3.  The following information (Items G4-G9) is provided for community floodplain management purposes.

**SECTION G - COMMUNITY INFORMATION (OPTIONAL)**

Check here if attachments

COMMENTS

SIGNATURE

DATE

TELEPHONE

ADDRESS

CITY

STATE

ZIP CODE

PROPERTY OWNER'S OR OWNERS AUTHORIZED REPRESENTATIVE'S NAME

The property owner or owner's authorized representative who completes Sections A, B, C (Items C3, h and C3i only), and E for Zone A (without a FEMA-issued or community-issued BFE) or Zone AO must sign here. The statements in Sections A, B, C, and E are correct to the best of my knowledge.

**SECTION F - PROPERTY OWNER (OR OWNER'S REPRESENTATIVE) CERTIFICATION**

E5. For Zone AO only: If no flood depth number is available, is the top of the bottom floor elevated in accordance with the community's floodplain management ordinance?  Yes  No  Unknown. The local official must certify this information in Section G.

E4. The top of the platform of machinery and/or equipment servicing the building is \_\_\_\_\_ ft.(m) \_\_\_\_\_ in.(cm) above or  below (check one) the highest adjacent grade. (Use natural grade, if available).

E3. For Building Diagrams 6-8 with openings (see page 7), the next higher floor or elevated floor (elevation b) of the building is \_\_\_\_\_ ft.(m) \_\_\_\_\_ in.(cm) above the highest adjacent grade. Complete items C3, h and C3i on front of form.

E2. The top of the bottom floor (including basement or enclosure) of the building is \_\_\_\_\_ ft.(m) \_\_\_\_\_ in.(cm) above or  below (check one) the highest adjacent grade. (Use natural grade, if available).

E1. Building Diagram Number \_\_\_\_ (Select the building diagram most similar to the building for which this certificate is being completed - see pages 6 and 7. If no diagram accurately represents the building, provide a sketch or photograph.)

Section C must be completed.  
For Zone AO and Zone A (without BFE), complete items E1 through E4. If the Elevation Certificate is intended for use as supporting information for a LOMA or LOMR-F,

**SECTION E - BUILDING ELEVATION INFORMATION (SURVEY NOT REQUIRED) FOR ZONE AO AND ZONE A (WITHOUT BFE)**

Check here if attachments

skirting is attached.

COMMENTS

Elevation of C3.C 4386.2 is to the bottom of the structural frame of manufactured home. Home is elevated on steel piers. No

Copy both sides of this Elevation Certificate for (1) community official, (2) insurance agent/company, and (3) building owner.

**SECTION D - SURVEYOR, ENGINEER, OR ARCHITECT CERTIFICATION (CONTINUED)**

For Insurance Company Use:	BUILDING STREET ADDRESS (including Apt., Unit, Suite, and/c No.) OR P.O. ROUTE AND BOX NO.	Policy Number
25050 N. Lantia Road		
CITY	STATE	Company NAIC Number
Paulden	AZ	86334

# ELEVATION CERTIFICATE

Important: Read the instructions on pages 1 - 5.

SECTION A - PROPERTY OWNER INFORMATION		For Insurance Company Use:
BUILDING OWNER'S NAME <u>TRANS APPLEBEE</u>		Policy Number
BUILDING STREET ADDRESS (Including Apt., Unit, Suite, and/or Bldg. No.) OR P.O. ROUTE AND BOX NO. <u>25050 N LARITA ROAD, P.O. 1686 CHINO VALLEY</u>		Company NAIC Number
CITY <u>PAULDEN</u>	STATE <u>AZ</u>	ZIP CODE <u>86334</u>
PROPERTY DESCRIPTION (Lot and Block Numbers, Tax Parcel Number, Legal Description, etc.) <u>APN 304-01-095T</u>		
BUILDING USE (e.g., Residential, Non-residential, Addition, Accessory, etc. Use comments section if necessary.) <u>RESIDENTIAL</u>		
LATITUDE/LONGITUDE (OPTIONAL) (##° - ##' - ###" or ###.####°)	HORIZONTAL DATUM: <input type="checkbox"/> NAD 1927 <input type="checkbox"/> NAD 1983	SOURCE: <input type="checkbox"/> GPS (Type: _____) <input type="checkbox"/> USGS Quad Map <input type="checkbox"/> Other: _____

## SECTION B - FLOOD INSURANCE RATE MAP (FIRM) INFORMATION

B1. NFIP COMMUNITY NAME & COMMUNITY NUMBER <u>YAVAPAI COUNTY, AZ</u>		B2. COUNTY NAME <u>YAVAPAI</u>		B3. STATE <u>AZ</u>	
B4. MAP AND PANEL NUMBER <u>040093-0585</u>	B5. SUFFIX <u>D</u>	B6. FIRM INDEX DATE <u>3-9-99</u>	B7. FIRM PANEL EFFECTIVE/REVISED DATE <u>26 JAN 2000</u>	B8. FLOOD ZONE(S) <u>AE</u>	B9. BASE FLOOD ELEVATION(S) (Zone AO, use depth of flooding) <u>4384.0</u>

B10. Indicate the source of the Base Flood Elevation (BFE) data or base flood depth entered in B9.  
 FIS Profile  FIRM  Community Determined  Other (Describe: \_\_\_\_\_)

B11. Indicate the elevation datum used for the BFE in B9:  NGVD 1929  NAVD 1988  Other (Describe: \_\_\_\_\_)

B12. Is the building located in a Coastal Barrier Resources System (CBRS) area or Otherwise Protected Area (OPA)?  Yes  No  
 Designation Date: \_\_\_\_\_

## SECTION C - BUILDING ELEVATION INFORMATION (SURVEY REQUIRED)


C1. Building elevations are based on:  Construction Drawings\*  Building Under Construction\*  Finished Construction  
 \*A new Elevation Certificate will be required when construction of the building is complete.

C2. Building Diagram Number 5 (Select the building diagram most similar to the building for which this certificate is being completed - see pages 4 and 5. If no diagram accurately represents the building, provide a sketch or photograph.)

C3. Elevations - Zones A1-A30, AE, AH, A (with BFE), VE, V1-V30, V (with BFE), AR, AR/A, AR/AE, AR/A1-A30, AR/AH, AR/AO  
 Complete Items C3a-i below according to the building diagram specified in Item C2. State the datum used. If the datum is different from the datum used for the BFE in Section B, convert the datum to that used for the BFE. Show field measurements and datum conversion calculation. Use the space provided or the Comments area of Section D or Section G, as appropriate, to document the datum conversion.  
 Datum NGVD 1929 Conversion/Comments \_\_\_\_\_

Elevation reference mark used RM 50-2 Does the elevation reference mark used appear on the FIRM?  Yes  No

<input type="checkbox"/> a) Top of bottom floor (including basement or enclosure)	<u>4387.5</u> ft.(m)
<input type="checkbox"/> b) Top of next higher floor	<u>NA</u> ft.(m)
<input type="checkbox"/> c) Bottom of lowest horizontal structural member (V-zones only)	<u>4386.2</u> ft.(m)
<input type="checkbox"/> d) Attached garage (top of slab)	<u>NA</u> ft.(m)
<input type="checkbox"/> e) Lowest elevation of machinery and/or equipment servicing the building	<u>NA</u> ft.(m)
<input type="checkbox"/> f) Lowest adjacent grade (LAG)	<u>4384.7</u> ft.(m)
<input type="checkbox"/> g) Highest adjacent grade (HAG)	<u>4386.8</u> ft.(m)
<input type="checkbox"/> h) No. of permanent openings (flood vents) within 1 ft. above adjacent grade	<u>NA</u>
<input type="checkbox"/> i) Total area of all permanent openings (flood vents) in C3h	<u>NA</u> sq. in. (sq. cm)

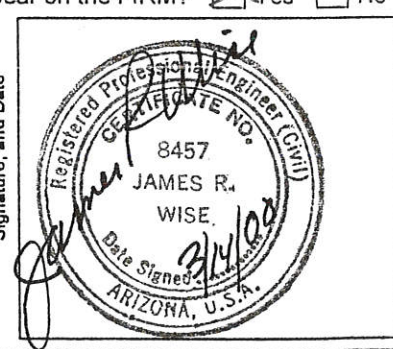

## SECTION D - SURVEYOR, ENGINEER, OR ARCHITECT CERTIFICATION

This certification is to be signed and sealed by a land surveyor, engineer, or architect authorized by law to certify elevation information. I certify that the information in Sections A, B, and C on this certificate represents my best efforts to interpret the data available. I understand that any false statement may be punishable by fine or imprisonment under 18 U.S. Code, Section 1001.

CERTIFIER'S NAME <u>JAMES R WISE</u>	LICENSE NUMBER <u>AZ PE 8457</u>
TITLE <u>PRINCIPAL</u>	COMPANY NAME <u>KEILEY WISE ENGINEERING INC</u>
ADDRESS <u>146 GROVE AVE</u>	CITY <u>PRESCOTT</u>
SIGNATURE <u>James R Wise</u>	STATE <u>AZ</u>
	ZIP CODE <u>86301</u>
	TELEPHONE

**IMPORTANT:** In these spaces, copy the corresponding information from Section A.


**SECTION D - SURVEYOR, ENGINEER, OR ARCHITECT CERTIFICATION (CONTINUED)**

Copy both sides of this Elevation Certificate for (1) community official, (2) insurance agent/company, and (3) building owner.

COMMENTS  
*ELEVATION OF C3.C. IS TO THE BOTTOM OF THE STRUCTURAL FRAME*  
*OF MANUFACTURED HOME. HOME IS ELEVATED ON STEEL PIERS ON CONCRETE.*  
*NO SKIRTING IS ATTACHED*

**SECTION E - BUILDING ELEVATION INFORMATION (SURVEY NOT REQUIRED) FOR ZONES AO and A (WITHOUT BFE)**

For Zones AO and A (without BFE), complete items E1 through E3. If the Elevation Certificate is intended for use as supporting information for a LOMA or LOMR-F, Section C must be completed.

E1. Building Diagram Number \_\_\_\_\_ (Select the building diagram most similar to the building for which this certificate is being completed - see pages 4 and 5. If no diagram accurately represents the building, provide a sketch or photograph.)

E2. The top of the bottom floor (including basement or enclosure) of the building is \_\_\_\_\_ ft.(m) \_\_\_\_\_ in.(cm) \_\_\_\_\_ above or \_\_\_\_\_ below (check one) the highest adjacent grade.

E3. For Zone AO only: If no flood depth number is available, is the top of the bottom floor elevated in accordance with the community's floodplain management ordinance?  Yes  No  Unknown. The local official must certify this information in Section G.

**SECTION F - PROPERTY OWNER (OR OWNER'S REPRESENTATIVE) CERTIFICATION**

The property owner or owner's authorized representative who completes Sections A, B, and E for Zone A (without a FEMA-issued or community-issued BFE) or Zone AO must sign here.

PROPERTY OWNER'S OR OWNER'S AUTHORIZED REPRESENTATIVE'S NAME \_\_\_\_\_

ADDRESS \_\_\_\_\_ CITY \_\_\_\_\_ STATE \_\_\_\_\_ ZIP CODE \_\_\_\_\_

SIGNATURE \_\_\_\_\_ DATE \_\_\_\_\_ TELEPHONE \_\_\_\_\_

COMMENTS \_\_\_\_\_

Check here if attachments \_\_\_\_\_

**SECTION G - COMMUNITY INFORMATION (OPTIONAL)**

The local official who is authorized by law or ordinance to administer the community's floodplain management ordinance can complete Sections A, B, C (or E), and G of this Elevation Certificate. Check the applicable box(es) and sign below.

G1.  The information in Section C was taken from other documentation that has been signed and embossed by a licensed surveyor, engineer, or architect who is authorized by state or local law to certify elevation information. (Indicate the source and date of the elevation data in the Comments area below.)

G2.  A community official completed Section E for a building located in Zone A (without a FEMA-issued or community-issued BFE) or Zone AO.

G3.  The following information (Items G4-G9) is provided for community floodplain management purposes.

G4. PERMIT NUMBER	G5. DATE PERMIT ISSUED	G6. DATE CERTIFICATE OF COMPLIANCE/OCCUPANCY ISSUED
-------------------	------------------------	---

G7. This permit has been issued for:  New Construction  Substantial Improvement

G8. Elevation of as-built lowest floor (including basement) of the building is: \_\_\_\_\_ ft.(m) Datum: \_\_\_\_\_

G9. BFE or (in Zone AO) depth of flooding at the building site is: \_\_\_\_\_ ft.(m) Datum: \_\_\_\_\_

LOCAL OFFICIAL'S NAME \_\_\_\_\_ TITLE \_\_\_\_\_ TELEPHONE \_\_\_\_\_ DATE \_\_\_\_\_ SIGNATURE \_\_\_\_\_ COMMENTS \_\_\_\_\_

Check here if attachments \_\_\_\_\_

Check here if attachments \_\_\_\_\_

# ELEVATION OF FLOODPLAIN PROPERTY

When Completed Return To: Yavapai County Flood Control District, 500 S. Marina St., Prescott, AZ, 86303  
(520) 771-3197 FAX 771-3427

DATE 1/26/00

ASSESSOR'S PARCEL NUMBER 304-01-095 T

SUBDIVISION NAME UNIT/PHASE AND LOT NUMBER METES & BOUNDS

OWNER TRAVIS APPLEBEE

SITUS ADDRESS \_\_\_\_\_


BASE BENCHMARK: Number RM 50-2 Elevation 4378.215

PROPERTY BENCHMARK SOUTHEAST PROP. CORNER EL. 4383.09


DESCRIPTION OF PROPERTY BENCHMARK 1/2" CAPPED REBAR

GROUND ELEVATIONS AT BUILDING SITE NW 4385.4, NE 4386.8, SE 4384.7  
(Please provide a minimum of three (3) elevations points, representative of the site)  
CENTER 4385.1 SW 4383.9

Sketch of Lot \_\_\_\_\_ Remarks \_\_\_\_\_  
(include location of property benchmark and building site elevations)

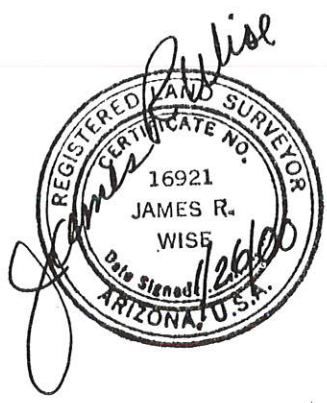

(Seal)

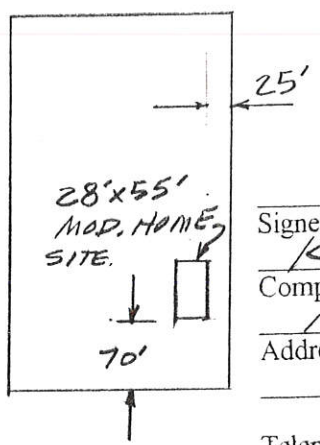

Signed KELLEY / WISE ENGR. INC.  
Company Name  
146 GROVE AVE  
Address  
PRESCOTT, AZ 86301  
Telephone (520) 771-1730

FOR YAVAPAI COUNTY FLOOD CONTROL DISTRICT USE: Date: 1-26-00

Base Flood Elevation 4384.0 + 1.0' = Regulatory Elevation 4385.0

\* ELEVATION DETERMINATIONS ARE BASED ON BEST AVAILABLE DATA WHEN CALCULATED. ELEVATIONS ARE SUBJECT TO CHANGE WHEN NEW OR REVISED FLOOD STUDIES, OR DATA IS SUPPLIED TO THE DISTRICT.

