

FEDERAL EMERGENCY MANAGEMENT AGENCY
NATIONAL FLOOD INSURANCE PROGRAM

O.M.B. No. 3067-0077
Expires July 31, 2002

ELEVATION CERTIFICATE

Important: Read the instructions on pages 1 - 7.

SECTION A - PROPERTY OWNER INFORMATION		For Insurance Company Use:	
BUILDING OWNER'S NAME <u>DARRELL L. AND BARBARA E. COLEMAN</u>		Policy Number	
BUILDING STREET ADDRESS (Including Apt., Unit, Suite, and/or Bldg. No.) OR P.O. ROUTE AND BOX NO. <u>25120 N. FEATHER MOUNTAIN ROAD</u>		Company NAIC Number	
CITY <u>PAULDEN</u>	STATE <u>AZ</u>	ZIP CODE	
PROPERTY DESCRIPTION (Lot and Block Numbers, Tax Parcel Number, Legal Description, etc.) <u>APN 304-01-1876</u>			
BUILDING USE (e.g., Residential, Non-residential, Addition, Accessory, etc. Use Comments section if necessary.) <u>RESIDENTIAL</u>			
LATITUDE/LONGITUDE (OPTIONAL) (##° - ##' - ###.###" or ##.####")		HORIZONTAL DATUM: SOURCE: <input type="checkbox"/> GPS (Type): <input type="checkbox"/> NAD 1927 <input type="checkbox"/> NAD 1983 <input type="checkbox"/> USGS Quad Map <input type="checkbox"/> Other:	

SECTION B - FLOOD INSURANCE RATE MAP (FIRM) INFORMATION

B1. NFIP COMMUNITY NAME & COMMUNITY NUMBER <u>Yavapai County 040093</u>		B2. COUNTY NAME <u>Yavapai</u>		B3. STATE <u>AZ</u>	
B4. MAP AND PANEL NUMBER <u>040093 0585</u>	B5. SUFFIX <u>Δ</u>	B6. FIRM INDEX DATE <u>3-9-99</u>	B7. FIRM PANEL EFFECTIVE/REVISED DATE <u>12-19-97</u>	B8. FLOOD ZONE(S) <u>A</u>	B9. BASE FLOOD ELEVATION(S) (Zone AO, use depth of flooding) <u>4385.5</u>

B10. Indicate the source of the Base Flood Elevation (BFE) data or base flood depth entered in B9.
 FIS Profile FIRM Community Determined Other (Describe):

B11. Indicate the elevation datum used for the BFE in B9: NGVD 1929 NAVD 1988 Other (Describe):

B12. Is the building located in a Coastal Barrier Resources System (CBRS) area or Otherwise Protected Area (OPA)? Yes No
Designation Date:

SECTION C - BUILDING ELEVATION INFORMATION (SURVEY REQUIRED)

C1. Building elevations are based on: Construction Drawings* Building Under Construction* Finished Construction
*A new Elevation Certificate will be required when construction of the building is complete.


C2. Building Diagram Number 1 (Select the building diagram most similar to the building for which this certificate is being completed - see pages 6 and 7. If no diagram accurately represents the building, provide a sketch or photograph.)

C3. Elevations - Zones A1-A30, AE, AH, A (with BFE), VE, V1-V30, V (with BFE), AR, AR/A, AR/AE, AR/A1-A30, AR/AH, AR/AO
Complete Items C3a-i below according to the building diagram specified in Item C2. State the datum used. If the datum is different from the datum used for the BFE in Section B, convert the datum to that used for the BFE. Show field measurements and datum conversion calculation. Use the space provided or the Comments area of Section D or Section G, as appropriate, to document the datum conversion.
Datum _____ Conversion/Comments _____

Elevation reference mark used RM 50-3 Does the elevation reference mark used appear on the FIRM? Yes No

<input checked="" type="checkbox"/> a) Top of bottom floor (including basement or enclosure)	<u>4386.52</u> ft.(m)
<input type="checkbox"/> b) Top of next higher floor	_____ ft.(m)
<input type="checkbox"/> c) Bottom of lowest horizontal structural member (V zones only)	_____ ft.(m)
<input checked="" type="checkbox"/> d) Attached garage (top of slab)	<u>4386.04</u> ft.(m)
<input type="checkbox"/> e) Lowest elevation of machinery and/or equipment servicing the building	_____ ft.(m)
<input checked="" type="checkbox"/> f) Lowest adjacent grade (LAG)	<u>4385.7</u> ft.(m)
<input checked="" type="checkbox"/> g) Highest adjacent grade (HAG)	<u>4385.8</u> ft.(m)
<input type="checkbox"/> h) No. of permanent openings (flood vents) within 1 ft. above adjacent grade	_____
<input type="checkbox"/> i) Total area of all permanent openings (flood vents) in C3h	_____ sq. in. (sq. cm)

License Number, Embossed Seal, Signature, and Date

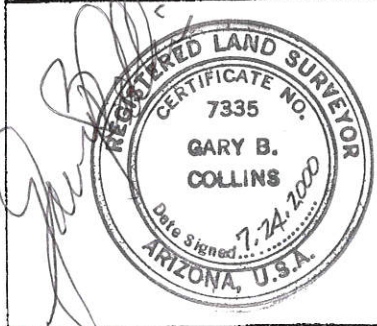

SECTION D - SURVEYOR, ENGINEER, OR ARCHITECT CERTIFICATION

This certification is to be signed and sealed by a land surveyor, engineer, or architect authorized by law to certify elevation information.
I certify that the information in Sections A, B, and C on this certificate represents my best efforts to interpret the data available.
I understand that any false statement may be punishable by fine or imprisonment under 18 U.S. Code, Section 1001.

CERTIFIER'S NAME <u>GARY B. COLLINS</u>	LICENSE NUMBER <u>L.S. 7335</u>
TITLE <u>REGISTERED LAND SURVEYOR</u>	COMPANY NAME <u>COLLINS SURVEYING SERVICES</u>
ADDRESS <u>2106 DINEH DRIVE</u>	CITY <u>PRESCOTT</u>
SIGNATURE <u>Gary B. Collins</u>	STATE <u>AZ</u>
	ZIP CODE <u>86305</u>
	DATE <u>7-24-2000</u>
	TELEPHONE <u>520-445-3579</u>

IMPORTANT: In these spaces, copy the corresponding information from Section A.			For Insurance Company Use:
BUILDING STREET ADDRESS (Including Apt., Ur. Suite, and/or Bldg. No.) OR P.O. ROUTE AND BOX NO. 25120 N. FEATHER MOUNTAIN ROAD			Policy Number
CITY PAULDEN	STATE AZ	ZIP CODE	Company NAIC Number

SECTION D - SURVEYOR, ENGINEER, OR ARCHITECT CERTIFICATION (CONTINUED)

Copy both sides of this Elevation Certificate for (1) community official, (2) insurance agent/company, and (3) building owner.

COMMENTS SITE BUILT RESIDENTIAL STRUCTURE IS IN ZONE A. ELEVATION OF TOP OF BOTTOM FLOOR IS 4386.52 FT. REQUIRED MINIMUM FINISH FLOOR ELEVATION 4386.52 AND BENCHMARK USED WAS RM 5D-3. FINISH FLOOR IS APPROX. 2' HIGHER THAN NATURAL GRADE. Check here if attachments

SECTION E - BUILDING ELEVATION INFORMATION (SURVEY NOT REQUIRED) FOR ZONE AO AND ZONE A (WITHOUT BFE)

For Zone AO and Zone A (without BFE), complete Items E1 through E4. If the Elevation Certificate is intended for use as supporting information for a LOMA or LOMR-F, Section C must be completed.

- E1. Building Diagram Number _____ (Select the building diagram most similar to the building for which this certificate is being completed - see pages 6 and 7. If no diagram accurately represents the building, provide a sketch or photograph.)
- E2. The top of the bottom floor (including basement or enclosure) of the building is _____ ft.(m) _____ in.(cm) _____ above or _____ below (check one) the highest adjacent grade.
- E3. For Building Diagrams 6-8 with openings (see page 7), the next higher floor or elevated floor (elevation b) of the building is _____ ft.(m) _____ in.(cm) above the highest adjacent grade.
- E4. For Zone AO only: If no flood depth number is available, is the top of the bottom floor elevated in accordance with the community's floodplain management ordinance? Yes No Unknown. The local official must certify this information in Section G.

SECTION F - PROPERTY OWNER (OR OWNER'S REPRESENTATIVE) CERTIFICATION

The property owner or owner's authorized representative who completes Sections A, B, and E for Zone A (without a FEMA-issued or community-issued BFE) or Zone AO must sign here.

PROPERTY OWNER'S OR OWNER'S AUTHORIZED REPRESENTATIVE'S NAME			
ADDRESS	CITY	STATE	ZIP CODE
SIGNATURE	DATE	TELEPHONE	
COMMENTS			

Check here if attachments

SECTION G - COMMUNITY INFORMATION (OPTIONAL)

The local official who is authorized by law or ordinance to administer the community's floodplain management ordinance can complete Sections A, B, C (or E), and G of this Elevation Certificate. Complete the applicable item(s) and sign below.

- G1. The information in Section C was taken from other documentation that has been signed and embossed by a licensed surveyor, engineer, or architect who is authorized by state or local law to certify elevation information. (Indicate the source and date of the elevation data in the Comments area below.)
- G2. A community official completed Section E for a building located in Zone A (without a FEMA-issued or community-issued BFE) or Zone AO.
- G3. The following information (Items G4-G9) is provided for community floodplain management purposes.

G4. PERMIT NUMBER	G5. DATE PERMIT ISSUED	G6. DATE CERTIFICATE OF COMPLIANCE/OCCUPANCY ISSUED
-------------------	------------------------	---

- G7. This permit has been issued for: New Construction Substantial Improvement
- G8. Elevation of as-built lowest floor (including basement) of the building is: _____ ft.(m) Datum: _____
- G9. BFE or (in Zone AO) depth of flooding at the building site is: _____ ft.(m) Datum: _____

LOCAL OFFICIAL'S NAME	TITLE
COMMUNITY NAME	TELEPHONE
SIGNATURE	DATE
COMMENTS	

Check here if attachments

ELEVATION OF FLOODPLAIN PROPERTY

When Completed Return To: Yavapai County Flood Control District, 500 S. Marina St., Prescott, AZ, 86303
(520) 771-3197 FAX 771-3427

DATE JULY 24, 2000

ASSESSOR'S PARCEL NUMBER 304-01-187G

SUBDIVISION NAME UNIT/PHASE AND LOT NUMBER M&B PARCEL; BK. 3722, PG. 615 YCR

OWNER DARRELL L. AND BARBARA E. COLEMAN

SITUS ADDRESS 25120 N. FEATHER MOUNTAIN ROAD

BASE BENCHMARK: Number RM 50-3 Elevation 4378.475

PROPERTY BENCHMARK ELEVATION = 4385.03


DESCRIPTION OF PROPERTY BENCHMARK TOP OF 1/2" REBAR, WITH CAP STAMPED "RAMSEY RLS 23383", FOUND AT NE. CORNER OF PAGE WIRE FENCE.

GROUND ELEVATIONS AT BUILDING SITE NORTH SIDE-4384.5', EAST-4384.6', SOUTH-4383.8'
(Please provide a minimum of three (3) elevations points, representative of the site)

Sketch of Lot
(include location of property benchmark and building site elevations)



(Seal)

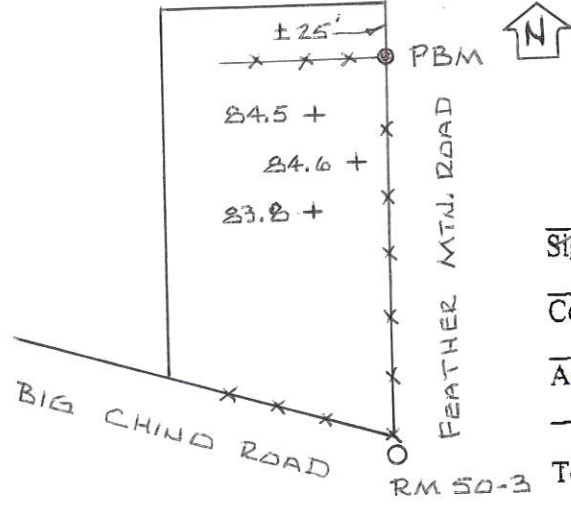

Remarks SITE BUILT STRUCTURE ON SOIL PAD. ELEVATIONS WERE TAKEN ON NATURAL GRADE AT TOE OF PAD

Signed Gary B. Collins
Company Name COLLINS SURVEYING SERVICES
Address 2106 DINEH DRIVE
PRESCOTT, AZ 86305
Telephone 520-445-3579

FOR YAVAPAI COUNTY FLOOD CONTROL DISTRICT USE: Date: _____

Base Flood Elevation + 1.0' = Regulatory Elevation

* ELEVATION DETERMINATIONS ARE BASED ON BEST AVAILABLE DATA WHEN CALCULATED. ELEVATIONS ARE SUBJECT TO CHANGE WHEN NEW OR REVISED FLOOD STUDIES, OR DATA IS SUPPLIED TO THE DISTRICT.