

ELEVATION CERTIFICATE

Important: Read the instructions on pages 1 - 7.

2 sided.

SECTION A - PROPERTY OWNER INFORMATION

For Insurance Company Use:

BUILDING OWNER	JUDITH E KRUMM	Policy Number
BUILDING ADDRESS (Street, Unit, Suite, and/or Bldg. No.) OR P.O. ROUTE AND BOX NO.	HAWK	Company NAIC Number
STATE	AZ	ZIP CODE
		86334

PROPERTY DESCRIPTION (Lot and Block Numbers, Tax Parcel Number, Legal Description, etc.)

PARCEL 304-02-020AH

BUILDING USE (e.g., Residential, Non-residential, Addition, Accessory, etc. Use Comments area if necessary.)

RESIDENTIAL

LATITUDE/LONGITUDE (OPTIONAL) (##° - ##' - ##.##" or ##.#####°)

HORIZONTAL DATUM: NAD 1927 NAD 1983

SOURCE: GPS (Type): _____
 USGS Quad Map Other: _____

SECTION B - FLOOD INSURANCE RATE MAP (FIRM) INFORMATION

B1. NFIP COMMUNITY NAME & COMMUNITY NUMBER	040093	B2. COUNTY NAME	YAVAPAI	B3. STATE	AZ
YAVAPAI COUNTY UNINCORPORATED AREA					
B4. MAP AND PANEL NUMBER	B5. SUFFIX	B6. FIRM INDEX DATE	B7. FIRM PANEL EFFECTIVE/REVISED DATE	B8. FLOOD ZONES	B9. BASE FLOOD ELEVATION(S)
04025C0970	F		JUNE 06 2001	AE	4383.6

B10. Indicate the source of the Base Flood Elevation (BFE) data or base flood depth entered in B9.

FIS Profile FIRM Community Determined Other (Describe): _____

B11. Indicate the elevation datum used for the BFE in B9: NGVD 1929 NAVD 1988 Other (Describe): NAD 27

B12. Is the building located in a Coastal Barrier Resources System (CBRS) area or Otherwise Protected Area (OPA)? Yes No
Designation Date: _____

SECTION C - BUILDING ELEVATION INFORMATION (SURVEY REQUIRED)


C1. Building elevations are based on: Construction Drawings* Building Under Construction* Finished Construction
*A new Elevation Certificate will be required when construction of the building is complete.

C2. Building Diagram Number 8 (Select the building diagram most similar to the building for which this certificate is being completed - see pages 6 and 7. If no diagram accurately represents the building, provide a sketch or photograph.)

C3. Elevations - Zones A1-A30, (AE) AH, A (with BFE), VE, V1-V30, V (with BFE), AR, AR/A, AR/AE, AR/A1-A30, AR/AH, AR/AO
Complete Items C3.a-i below according to the building diagram specified in Item C2. State the datum used. If the datum is different from the datum used for the BFE in Section B, convert the datum to that used for the BFE. Show field measurements and datum conversion calculation. Use the space provided or the Comments area of Section D or Section G, as appropriate, to document the datum conversion.
Datum _____ Conversion/Comments _____
Elevation reference mark used RM 306 Does the elevation reference mark used appear on the FIRM? Yes No

<input type="checkbox"/> a) Top of bottom floor (including basement or enclosure)	<u>4382.09</u> ft.(m)
<input type="checkbox"/> b) Top of next higher floor	<u>4386.23</u> ft.(m)
<input type="checkbox"/> c) Bottom of lowest horizontal structural member (V zones only)	<u>NA</u> ft.(m)
<input type="checkbox"/> d) Attached garage (top of slab)	<u>NA</u> ft.(m)
<input type="checkbox"/> e) Lowest elevation of machinery and/or equipment servicing the building (Describe in a Comments area.)	<u>NA</u> ft.(m)
<input type="checkbox"/> f) Lowest adjacent (finished) grade (LAG)	<u>4381.87</u> ft.(m)
<input type="checkbox"/> g) Highest adjacent (finished) grade (HAG)	<u>4382.59</u> ft.(m)
<input type="checkbox"/> h) No. of permanent openings (flood vents) within 1 ft. above adjacent grade	<u>4</u>
<input type="checkbox"/> i) Total area of all permanent openings (flood vents) in C3.h	<u>2640</u> sq. in. (sq. cm)

License Number, Embossed Seal, Signature, and Date

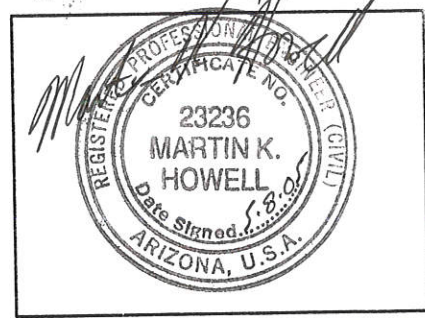

SECTION D - SURVEYOR, ENGINEER, OR ARCHITECT CERTIFICATION

This certification is to be signed and sealed by a land surveyor, engineer, or architect authorized by law to certify elevation information. I certify that the information in Sections A, B, and C on this certificate represents my best efforts to interpret the data available. I understand that any false statement may be punishable by fine or imprisonment under 18 U.S. Code, Section 1001.

CERTIFIER'S NAME	MARTIN KEVIN HOWELL	LICENSE NUMBER	AZ 23236 (CIVIL)
TITLE	PROJECT MANAGER	COMPANY NAME	CIVILTEC ENGINEERING INC
ADDRESS	2050 N WILLOW CREEK RD	CITY	PRESCOTT
		STATE	AZ
		ZIP CODE	86301
SIGNATURE	Martin K Howell	DATE	5.8.05
		TELEPHONE	(928) 771-2376

Check here if attachments

COMMENTS

SIGNATURE

COMMUNITY NAME

LOCAL OFFICIAL'S NAME

G9. BFE or (in Zone AO) depth of flooding at the building site is:

G8. Elevation of as-built lowest floor (including basement) of the building is:

G7. This permit has been issued for: New Construction Substantial Improvement

G4. PERMIT NUMBER	G5. DATE PERMIT ISSUED	G6. DATE CERTIFICATE OF COMPLIANCE/OCCUPANCY ISSUED
-------------------	------------------------	---

G3. The following information (Items G4-G9) is provided for community floodplain management purposes.

G2. A community official completed Section E for a building located in Zone A (without a FEMA-issued or community-issued BFE) or Zone AO.

G1. The information in Section C was taken from other documentation that has been signed and embossed by a licensed surveyor, engineer, or architect who is authorized by state or local law to certify elevation information. (Indicate the source and date of the elevation data in the Comments area below.)

The local official who is authorized by law or ordinance to administer the community's floodplain management ordinance can complete Sections A, B, C (or E), and G of this Elevation Certificate. Complete the applicable item(s) and sign below.

SECTION G - COMMUNITY INFORMATION (OPTIONAL)

Check here if attachments

COMMENTS

SIGNATURE

ADDRESS

DATE

CITY

STATE

ZIP CODE

TELEPHONE

PROPERTY OWNER'S OR OWNER'S AUTHORIZED REPRESENTATIVE'S NAME

The property owner or owner's authorized representative who completes Sections A, B, C (Items C3, h and C3.i only), and E for Zone A (without a FEMA-issued or community-issued BFE) or Zone AO must sign here. The statements in Sections A, B, C, and E are correct to the best of my knowledge.

SECTION F - PROPERTY OWNER (OR OWNER'S REPRESENTATIVE) CERTIFICATION

E5. For Zone AO only: If no flood depth number is available, is the top of the bottom floor elevated in accordance with the community's floodplain management ordinance? Yes No Unknown. The local official must certify this information in Section G.

E4. The top of the platform or machinery and/or equipment servicing the building is ft. in. (cm) above or below (check one) the highest adjacent grade. (Use natural grade, if available.)

E3. For Building Diagrams 6-8 with openings (see page 7), the next higher floor or elevated floor (elevation b) of the building is ft. (m) in. (cm) above the highest adjacent grade.

E2. The top of the bottom floor (including basement or enclosure) of the building is ft. (m) in. (cm) above or below (check one) the highest adjacent grade. (Use natural grade, if available.)

E1. Building Diagram Number (Select the building diagram most similar to the building for which this certificate is being completed - see pages 6 and 7. If no diagram accurately represents the building, provide a sketch or photograph.)

For Zone AO and Zone A (without BFE), complete items E1, through E4. If the Elevation Certificate is intended for use as supporting information for a LOMA or LOMR-F, Section C must be completed.

SECTION E - BUILDING ELEVATION INFORMATION (SURVEY NOT REQUIRED) FOR ZONE AO AND ZONE A (WITHOUT BFE)

Check here if attachments

COMMENTS

Copy both sides of this Elevation Certificate for (1) community official, (2) insurance agent/company, and (3) building owner.

SECTION D - SURVEYOR, ENGINEER, OR ARCHITECT CERTIFICATION (CONTINUED)

For Insurance Company Use:	Policy Number	STATE	ZIP CODE	Company NAIC Number
BUILDING STREET ADDRESS (Including Apt., U		CITY		
site, and/or Bldg. No.) OR P.O. ROUTE AND BOX NO.				

IMPORTANT: In these spaces, copy the corresponding information from Section A.

FINISH FLOOR IS 2.63' ABOVE BASE FLOOD ELEVATION

ELEVATION OF FLOODPLAIN PROPERTY

ORIG
Parcel # 970

When Completed Return To: YAVAPAI COUNTY DEVELOPMENT SERVICES - FL

500 S. Marina St., Prescott, AZ, 86303 (928) 771-3197 FAX (928) 771-3427 Office: P
10 S. 6th St., Cottonwood, AZ 86326 (928) 639-8151 FAX (928) 639-8118 Cotton

DATE 3.17.04

ASSESSOR'S PARCEL NUMBER 304-02-020A

SUBDIVISION NAME UNIT/PHASE AND LOT NUMBER N/A

OWNER LARRY D & JUDITH E KRUMM

SITUS ADDRESS 24320 N SUN HAWK, PAULDEN AZ

BASE BENCHMARK: Number FCDYCRM Elevation 4371.41
1429


PROPERTY BENCHMARK 1/2" Rebar 165' S of NE Cor along Fence El. 4381.34

DESCRIPTION OF PROPERTY BENCHMARK 1/2" Rebar 165' S of NE Cor along Fence
1/2" Rebar 158' W of NE Corner along Fence El 4381.78

GROUND ELEVATIONS AT BUILDING SITE 4381.70, 4381.48, 4381.47
(Please provide a minimum of three (3) elevation points, representative of the site)

Sketch of Lot
(include location of property benchmark and building site elevations)

Remarks See Attached
site topo

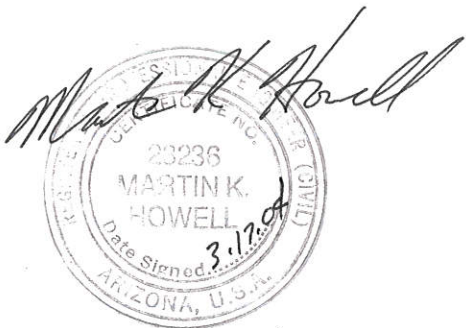

(Seal)

Marti K Howell
Signed
CIVILTEC ENGINEERING INC
Company Name
325 W Goodwin St
Address
Prescott Az 86303
Telephone 928: 771-2376

FOR YAVAPAI COUNTY FLOOD CONTROL DISTRICT USE: Date: _____

Base Flood Elevation + 1.0' = Regulatory Elevation

* ELEVATION DETERMINATIONS ARE BASED ON BEST AVAILABLE DATA WHEN CALCULATED. ELEVATIONS ARE SUBJECT TO CHANGE WHEN NEW OR REVISED FLOOD STUDIES OR DATA IS SUPPLIED TO THE DISTRICT.

