

**ELEVATION CERTIFICATE**

Important: Read the instructions on pages 1 - 7.

**SECTION A - PROPERTY OWNER INFORMATION**

BUILDING OWNER'S NAME <u>Tracy Sharp</u>		For Insurance Company Use:	
BUILDING STREET ADDRESS (Including Apt., Unit, Suite, and/or Bldg. No.) OR P.O. ROUTE AND BOX NO. <u>301 W La Jolla Lane</u>		Policy Number	
CITY <u>Paulden</u>	STATE <u>Arizona</u>	ZIP CODE <u>86334</u>	
PROPERTY DESCRIPTION (Lot and Block Numbers, Tax Parcel Number, Legal Description, etc.) <u>APN# 304-04-339A</u>			
BUILDING USE (e.g., Residential, Non-residential, Addition, Accessory, etc. Use Comments area if necessary.) <u>Residential</u>			
LATITUDE/LONGITUDE (OPTIONAL) (##° - ##' - ##.###" or ##.#####°)	HORIZONTAL DATUM: <input type="checkbox"/> NAD 1927 <input type="checkbox"/> NAD 1983	SOURCE: <input type="checkbox"/> GPS (Type): _____ <input type="checkbox"/> USGS Quad Map <input type="checkbox"/> Other: _____	

**SECTION B - FLOOD INSURANCE RATE MAP (FIRM) INFORMATION**

B1. NFIP COMMUNITY NAME & COMMUNITY NUMBER <u>Yavapai County 040093</u>		B2. COUNTY NAME <u>Yavapai County</u>		B3. STATE <u>Arizona</u>	
B4. MAP AND PANEL NUMBER <u>04025C990</u>	B5. SUFFIX <u>F</u>	B6. FIRM INDEX DATE <u>6/6/01</u>	B7. FIRM PANEL EFFECTIVE/REVISED DATE <u>6/6/01</u>	B8. FLOOD ZONES <u>AE</u>	B9. BASE FLOOD ELEVATION(S) <u>4397.6</u>

B10. Indicate the source of the Base Flood Elevation (BFE) data or base flood depth entered in B9.  
 FIS Profile  FIRM  Community Determined  Other (Describe): \_\_\_\_\_

B11. Indicate the elevation datum used for the BFE in B9:  NGVD 1929  NAVD 1988  Other (Describe): \_\_\_\_\_

B12. Is the building located in a Coastal Barrier Resources System (CBRS) area or Otherwise Protected Area (OPA)?  Yes  No  
Designation Date: \_\_\_\_\_

**SECTION C - BUILDING ELEVATION INFORMATION (SURVEY REQUIRED)**


C1. Building elevations are based on:  Construction Drawings\*  Building Under Construction\*  Finished Construction  
\*A new Elevation Certificate will be required when construction of the building is complete.

C2. Building Diagram Number 8 (Select the building diagram most similar to the building for which this certificate is being completed - see pages 6 and 7. If no diagram accurately represents the building, provide a sketch or photograph.)

C3. Elevations - Zones A1-A30, AE, AH, A (with BFE), VE, V1-V30, V (with BFE), AR, AR/A, AR/AE, AR/A1-A30, AR/AH, AR/AO  
Complete Items C3.a-i below according to the building diagram specified in Item C2. State the datum used. If the datum is different from the datum used for the BFE in Section B, convert the datum to that used for the BFE. Show field measurements and datum conversion calculation. Use the space provided or the Comments area of Section D or Section G, as appropriate, to document the datum conversion.  
Datum NGVD 29' Conversion/Comments \_\_\_\_\_  
Elevation reference mark used RM22 FERM 1411 Does the elevation reference mark used appear on the FIRM?  Yes  No

<input type="checkbox"/> a) Top of bottom floor (including basement or enclosure)	<u>4396</u>	<u>.40</u>	ft.(m)
<input type="checkbox"/> b) Top of next higher floor	<u>4400</u>	<u>.20</u>	ft.(m)
<input type="checkbox"/> c) Bottom of lowest horizontal structural member (V zones only)	<u>4398</u>	<u>.66</u>	ft.(m)
<input type="checkbox"/> d) Attached garage (top of slab)	<u>N/A</u>		ft.(m)
<input type="checkbox"/> e) Lowest elevation of machinery and/or equipment servicing the building (Describe in a Comments area.)	<u>N/A</u>		ft.(m)
<input type="checkbox"/> f) Lowest adjacent (finished) grade (LAG)	<u>4396.</u>	<u>.00</u>	ft.(m)
<input type="checkbox"/> g) Highest adjacent (finished) grade (HAG)	<u>4396.</u>	<u>.60</u>	ft.(m)
<input type="checkbox"/> h) No. of permanent openings (flood vents) within 1 ft. above adjacent grade	<u>2 LARGE</u>		
<input type="checkbox"/> i) Total area of all permanent openings (flood vents) in C3.h	<u>±4000</u> sq. in. (sq. cm)		

License Number, Embossed Seal, Signature, and Date

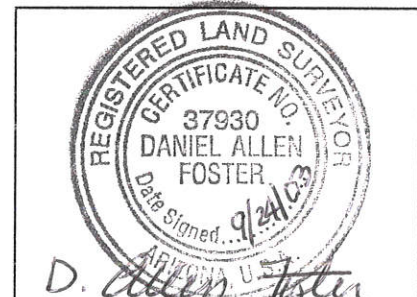

**SECTION D - SURVEYOR, ENGINEER, OR ARCHITECT CERTIFICATION**

This certification is to be signed and sealed by a land surveyor, engineer, or architect authorized by law to certify elevation information. I certify that the information in Sections A, B, and C on this certificate represents my best efforts to interpret the data available. I understand that any false statement may be punishable by fine or imprisonment under 18 U.S. Code, Section 1001.

CERTIFIER'S NAME <u>D. ALLEN FOSTER</u>	LICENSE NUMBER <u>RLS # 37930</u>
TITLE <u>REGISTERED LAND SURVEYOR</u>	COMPANY NAME <u>FOSTCO SURVEYING</u>
ADDRESS <u>P.O. Box 4363</u>	CITY <u>CHINO VALLEY</u>
SIGNATURE <u>D. Allen Foster</u>	DATE <u>9/24/03</u>
	STATE <u>AZ</u>
	ZIP CODE <u>86323</u>
	TELEPHONE <u>928-710-3813</u>



**IMPORTANT: In these spaces, copy the corresponding information from Section A.**

BUILDING STREET ADDRESS (Including Apt., Unit, Suite, and/or Bldg. No.) OR P.O. ROUTE AND BOX NO.

301 W. LAJOLLA LANE

For Insurance Company Use:

Policy Number

CITY

PAULDEN

STATE

AZ

ZIP CODE

86334

Company NAIC Number

**SECTION D - SURVEYOR, ENGINEER, OR ARCHITECT CERTIFICATION (CONTINUED)**

Copy both sides of this Elevation Certificate for (1) community official, (2) insurance agent/company, and (3) building owner.

COMMENTS

ELEVATION OF C3-C IS TO THE BOTTOM OF THE STRUCTURAL FRAME OF A MANUFACTURED HOME. THE HOME IS ELEVATED ON JACKS. THE HOME HAS SKIRTING AND WAS LEFT OPEN ON THE NORTH & SOUTH END FOR FLOOD PURPOSES.

Check here if attachments

**SECTION E - BUILDING ELEVATION INFORMATION (SURVEY NOT REQUIRED) FOR ZONE AO AND ZONE A (WITHOUT BFE)**

For Zone AO and Zone A (without BFE), complete Items E1. through E4. If the Elevation Certificate is intended for use as supporting information for a LOMA or LOMR-F, Section C must be completed.

- E1. Building Diagram Number \_\_\_\_\_ (Select the building diagram most similar to the building for which this certificate is being completed – see pages 6 and 7. If no diagram accurately represents the building, provide a sketch or photograph.)
- E2. The top of the bottom floor (including basement or enclosure) of the building is \_\_\_\_\_ ft.(m) \_\_\_\_\_ in.(cm) \_\_\_\_\_ above or \_\_\_\_\_ below (check one) the highest adjacent grade. (Use natural grade, if available.)
- E3. For Building Diagrams 6-8 with openings (see page 7), the next higher floor or elevated floor (elevation b) of the building is \_\_\_\_\_ ft.(m) \_\_\_\_\_ in.(cm) above the highest adjacent grade.
- E4. The top of the platform of machinery and/or equipment servicing the building is \_\_\_\_\_ ft. (m) \_\_\_\_\_ in. (cm) \_\_\_\_\_ above or \_\_\_\_\_ below (check one) the highest adjacent grade. (Use natural grade, if available.)
- E5. For Zone AO only: If no flood depth number is available, is the top of the bottom floor elevated in accordance with the community's floodplain management ordinance?  Yes  No  Unknown. The local official must certify this information in Section G.

**SECTION F - PROPERTY OWNER (OR OWNER'S REPRESENTATIVE) CERTIFICATION**

The property owner or owner's authorized representative who completes Sections A, B, C (Items C3.h and C3.i only), and E for Zone A (without a FEMA-issued or community-issued BFE) or Zone AO must sign here. The statements in Sections A, B, C, and E are correct to the best of my knowledge.

PROPERTY OWNER'S OR OWNER'S AUTHORIZED REPRESENTATIVE'S NAME

ADDRESS CITY STATE ZIP CODE

SIGNATURE DATE TELEPHONE

COMMENTS

Check here if attachments

**SECTION G - COMMUNITY INFORMATION (OPTIONAL)**

The local official who is authorized by law or ordinance to administer the community's floodplain management ordinance can complete Sections A, B, C (or E), and G of this Elevation Certificate. Complete the applicable item(s) and sign below.

- G1.  The information in Section C was taken from other documentation that has been signed and embossed by a licensed surveyor, engineer, or architect who is authorized by state or local law to certify elevation information. (Indicate the source and date of the elevation data in the Comments area below.)
- G2.  A community official completed Section E for a building located in Zone A (without a FEMA-issued or community-issued BFE) or Zone AO.
- G3.  The following information (Items G4-G9) is provided for community floodplain management purposes.

G4. PERMIT NUMBER	G5. DATE PERMIT ISSUED	G6. DATE CERTIFICATE OF COMPLIANCE/OCCUPANCY ISSUED
-------------------	------------------------	---

G7. This permit has been issued for:  New Construction  Substantial Improvement

G8. Elevation of as-built lowest floor (including basement) of the building is: \_\_\_\_\_ ft.(m) Datum: \_\_\_\_\_

G9. BFE or (in Zone AO) depth of flooding at the building site is: \_\_\_\_\_ ft.(m) Datum: \_\_\_\_\_

LOCAL OFFICIAL'S NAME TITLE

COMMUNITY NAME TELEPHONE

SIGNATURE DATE

COMMENTS

Check here if attachments



# ELEVATION OF FLOODPLAIN PROPERTY

When Completed Return To: Yavapai County Development Services – Floodplain Unit  
500 S. Marina St., Prescott, AZ, 86303 (928) 771-3197 FAX 771-3427

DATE 11/14/02

ASSESSOR'S PARCEL NUMBER 304-04-339A

SUBDIVISION NAME UNIT/PHASE AND LOT NUMBER HOLIDAY LAKE ESTATES LOT 438

OWNER TRACY SHARP

SITUS ADDRESS LA JOLLA LN

BASE BENCHMARK: Number RM-22 ERM 1411 Elevation 4393.79'



PROPERTY BENCHMARK ① 1/2" RB @ SE COR. = 4395.56' ② 1/2" RB (BENCH) = 4395.93'

DESCRIPTION OF PROPERTY BENCHMARK 1/2" REBAR STANDING ± 0.20' ABOVE GROUND

GROUND ELEVATIONS AT BUILDING SITE ③ = 4396.01' ④ = 4396.20' ⑤ 4396.15'  
(Please provide a minimum of three (3) elevations points, representative of the site)

Sketch of Lot  
(include location of property benchmark and building site elevations)

Remarks PROPERTY IS FLAT  
WITH A DITCH CUT IN  
ON THE SOUTH PROPERTY LINE.

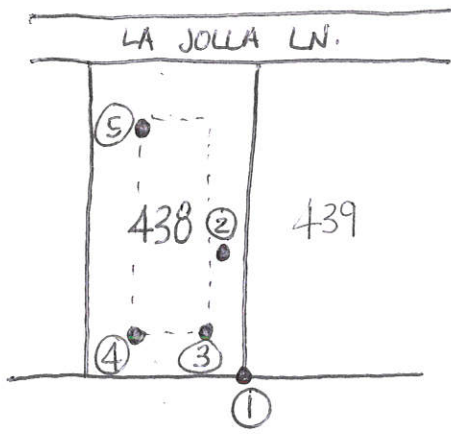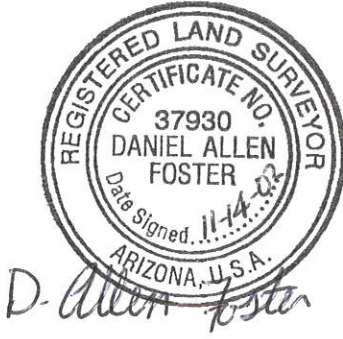

D. Allen Foster  
Signed  
D. ALLEN FOSTER R.L.S. #37930  
Company Name  
P.O. Box 4363  
Address  
CHINO VALLEY, AZ 86323  
Telephone 928-636-0095

FOR YAVAPAI COUNTY FLOOD CONTROL DISTRICT USE: Date: \_\_\_\_\_

Base Flood Elevation + 1.0' = Regulatory Elevation

\* ELEVATION DETERMINATIONS ARE BASED ON BEST AVAILABLE DATA WHEN CALCULATED. ELEVATIONS ARE SUBJECT TO CHANGE WHEN NEW OR REVISED FLOOD STUDIES OR DATA IS SUPPLIED TO THE DISTRICT.