

FEDERAL EMERGENCY MANAGEMENT AGENCY
NATIONAL FLOOD INSURANCE PROGRAM

O.M.B. No. 3067-0077
Expires December 31, 2005

ELEVATION CERTIFICATE

Important: Read the instructions on pages 1 - 7.

SECTION A - PROPERTY OWNER INFORMATION

BUILDING OWNER'S NAME GREAT REPUBLIC MORTGAGE	For Insurance Company Use: Policy Number
BUILDING STREET ADDRESS (Including Apt., Unit, Suite, and/or Bldg. No.) OR P.O. ROUTE AND BOX NO. 24435 N. CLEVELAND ST.	Company NAIC Number
CITY	STATE ZIP CODE

PROPERTY DESCRIPTION (Lot and Block Numbers, Tax Parcel Number, Legal Description, etc.)

LOT 273, SUNSET MOBILE SITES APN # 304-07-273

BUILDING USE (e.g., Residential, Non-residential, Addition, Accessory, etc. Use Comments area if necessary.)

RESIDENTIAL

LATITUDE/LONGITUDE (OPTIONAL) HORIZONTAL DATUM: SOURCE: GPS (Type):
(##° - ##' - ##.###" or ##.#####") NAD 1927 NAD 1983 USGS Quad Map Other:

SECTION B - FLOOD INSURANCE RATE MAP (FIRM) INFORMATION

B1. NFIP COMMUNITY NAME & COMMUNITY NUMBER Yavapai County 040093		B2. COUNTY NAME Yavapai		B3. STATE AZ	
B4. MAP AND PANEL NUMBER 04025C0990	B5. SUFFIX F	B6. FIRM INDEX DATE 6-6-01	B7. FIRM PANEL EFFECTIVE/REVISED DATE 6-6-01	B8. FLOOD ZONES AE	B9. BASE FLOOD ELEVATION(S) 4420.0

B10. Indicate the source of the Base Flood Elevation (BFE) data or base flood depth entered in B9.

FIS Profile FIRM Community Determined Other (Describe):

B11. Indicate the elevation datum used for the BFE in B9: NGVD 1929 NAVD 1988 Other (Describe):

B12. Is the building located in a Coastal Barrier Resources System (CBRS) area or Otherwise Protected Area (OPA)? Yes No
Designation Date:

SECTION C - BUILDING ELEVATION INFORMATION (SURVEY REQUIRED)

C1. Building elevations are based on: Construction Drawings* Building Under Construction* Finished Construction
*A new Elevation Certificate will be required when construction of the building is complete.


C2. Building Diagram Number **8** (Select the building diagram most similar to the building for which this certificate is being completed - see pages 6 and 7. If no diagram accurately represents the building, provide a sketch or photograph.)

C3. Elevations - Zones A1-A30, AE, AH, A (with BFE), VE, V1-V30, V (with BFE), AR, AR/A, AR/AE, AR/A1-A30, AR/AH, AR/AO
Complete Items C3.a-i below according to the building diagram specified in Item C2. State the datum used. If the datum is different from the datum used for the BFE in Section B, convert the datum to that used for the BFE. Show field measurements and datum conversion calculation. Use the space provided or the Comments area of Section D or Section G, as appropriate, to document the datum conversion.
Datum **RM 23** Conversion/Comments

Elevation reference mark used _____ Does the elevation reference mark used appear on the FIRM? Yes No

<input type="checkbox"/> a) Top of bottom floor (including basement or enclosure)	4419	35	ft.(m)
<input type="checkbox"/> b) Top of next higher floor	4422	70	ft.(m)
<input type="checkbox"/> c) Bottom of lowest horizontal structural member (V zones only)	N/A		ft.(m)
<input type="checkbox"/> d) Attached garage (top of slab)	N/A		ft.(m)
<input type="checkbox"/> e) Lowest elevation of machinery and/or equipment servicing the building (Describe in a Comments area.)	4421	71	ft.(m)
<input type="checkbox"/> f) Lowest adjacent (finished) grade (LAG)	4419	29	ft.(m)
<input type="checkbox"/> g) Highest adjacent (finished) grade (HAG)	4420	45	ft.(m)
<input type="checkbox"/> h) No. of permanent openings (flood vents) within 1 ft. above adjacent grade	7		
<input type="checkbox"/> i) Total area of all permanent openings (flood vents) in C3.h	725		sq. in. (sq. cm)

License Number, Embossed Seal, Signature, and Date

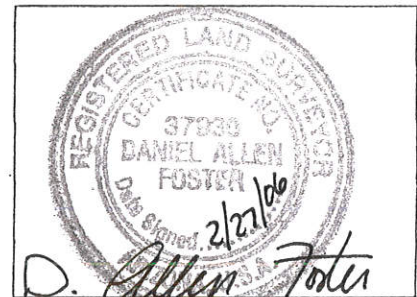

SECTION D - SURVEYOR, ENGINEER, OR ARCHITECT CERTIFICATION

This certification is to be signed and sealed by a land surveyor, engineer, or architect authorized by law to certify elevation information. I certify that the information in Sections A, B, and C on this certificate represents my best efforts to interpret the data available. I understand that any false statement may be punishable by fine or imprisonment under 18 U.S. Code, Section 1001.

CERTIFIER'S NAME **D. ALLEN FOSTER** LICENSE NUMBER **RLS # 37930**

TITLE **OWNER** COMPANY NAME **FOSTCO SURVEYING**

ADDRESS **P.O. Box 4363** CITY **CHINO VALLEY** STATE **AZ** ZIP CODE **86323**

SIGNATURE **D. Allen Foster** DATE **2/27/06** TELEPHONE **(928) 636-9184**



IMPORTANT: In these spaces, copy the corresponding information from Section A.			For Insurance Company Use:
BUILDING STREET ADDRESS (Including Apt., Unit, Suite, and/or Bldg. No.) OR P.O. ROUTE AND BOX NO. 24435 N. CLEVELAND ST.			Policy Number
CITY	STATE	ZIP CODE	Company NAIC Number

SECTION D - SURVEYOR, ENGINEER, OR ARCHITECT CERTIFICATION (CONTINUED)

Copy both sides of this Elevation Certificate for (1) community official, (2) insurance agent/company, and (3) building owner.

COMMENTS HOME IS A DOUBLEWIDE MANUFACTURED HOME ON JACK. ELEVATION OF C3-C IS TO THE LOWEST STRUCTURAL FRAME, AND HAS AN ELEVATION OF 4421.24. THE ELEVATION OF LOWEST MACHINERY IS THE BOTTOM OF THE ELECTRICAL BOX.

Check here if attachments

SECTION E - BUILDING ELEVATION INFORMATION (SURVEY NOT REQUIRED) FOR ZONE AO AND ZONE A (WITHOUT BFE)

For Zone AO and Zone A (without BFE), complete Items E1. through E4. If the Elevation Certificate is intended for use as supporting information for a LOMA or LOMR-F, Section C must be completed.

- E1. Building Diagram Number ____ (Select the building diagram most similar to the building for which this certificate is being completed – see pages 6 and 7. If no diagram accurately represents the building, provide a sketch or photograph.)
- E2. The top of the bottom floor (including basement or enclosure) of the building is ____ ft.(m) ____ in.(cm) ____ above or ____ below (check one) the highest adjacent grade. (Use natural grade, if available.)
- E3. For Building Diagrams 6-8 with openings (see page 7), the next higher floor or elevated floor (elevation b) of the building is ____ ft.(m) ____ in.(cm) above the highest adjacent grade. Complete Items C3.h and C3.i on front of form.
- E4. For Zone AO only: If no flood depth number is available, is the top of the bottom floor elevated in accordance with the community's floodplain management ordinance? Yes No Unknown. The local official must certify this information in Section G.

SECTION F - PROPERTY OWNER (OR OWNER'S REPRESENTATIVE) CERTIFICATION

The property owner or owner's authorized representative who completes Sections A, B, C (Items C3.h and C3.i only), and E for Zone A (without a FEMA-issued or community-issued BFE) or Zone AO must sign here. *The statements in Sections A, B, C, and E are correct to the best of my knowledge.*

PROPERTY OWNER'S OR OWNER'S AUTHORIZED REPRESENTATIVE'S NAME _____

ADDRESS	CITY	STATE	ZIP CODE
SIGNATURE	DATE	TELEPHONE	
COMMENTS			

Check here if attachments

SECTION G - COMMUNITY INFORMATION (OPTIONAL)

The local official who is authorized by law or ordinance to administer the community's floodplain management ordinance can complete Sections A, B, C (or E), and G of this Elevation Certificate. Complete the applicable item(s) and sign below.

- G1. The information in Section C was taken from other documentation that has been signed and embossed by a licensed surveyor, engineer, or architect who is authorized by state or local law to certify elevation information. (Indicate the source and date of the elevation data in the Comments area below.)
- G2. A community official completed Section E for a building located in Zone A (without a FEMA-issued or community-issued BFE) or Zone AO.
- G3. The following information (Items G4-G9) is provided for community floodplain management purposes.

G4. PERMIT NUMBER	G5. DATE PERMIT ISSUED	G6. DATE CERTIFICATE OF COMPLIANCE/OCCUPANCY ISSUED
-------------------	------------------------	---

- G7. This permit has been issued for: New Construction Substantial Improvement
- G8. Elevation of as-built lowest floor (including basement) of the building is: _____ ft.(m) Datum: _____
- G9. BFE or (in Zone AO) depth of flooding at the building site is: _____ ft.(m) Datum: _____

LOCAL OFFICIAL'S NAME	TITLE
COMMUNITY NAME	TELEPHONE
SIGNATURE	DATE
COMMENTS	

Check here if attachments

ELEVATION OF FLOODPLAIN PROPERTY

When Completed Return To: Yavapai County Development Services – Floodplain Unit
500 S. Marina St., Prescott, AZ, 86303 (928) 771-3197 FAX 771-3427

DATE 1/09/06

ASSESSOR'S PARCEL NUMBER APN#304-07-273

SUBDIVISION NAME UNIT/PHASE AND LOT NUMBER SUNSET MOBILE SITES LOT 273

OWNER GREAT REPUBLIC MORT.

SITUS ADDRESS 24435 N. CLEVELAND ST.

BASE BENCHMARK: Number RM 23 (ERM-1415) Elevation 4400.46'


PROPERTY BENCHMARK ① SW. PROP. COR. 1/2" FAMAS REBAR, ② BENCH 1/2" REBAR

DESCRIPTION OF PROPERTY BENCHMARK ① EL=4418.83, ② EL=4418.8'

GROUND ELEVATIONS AT BUILDING SITE ③ EL=4418.70' ④ EL=4419.55' ⑤ 4421.05'
(Please provide a minimum of three (3) elevations points, representative of the site)


Sketch of Lot
(include location of property benchmark and building site elevations)

Remarks LOT IS RELATIVELY
FLAT WITH A SLIGHT SLOPE
FROM NORTH TO SOUTH.

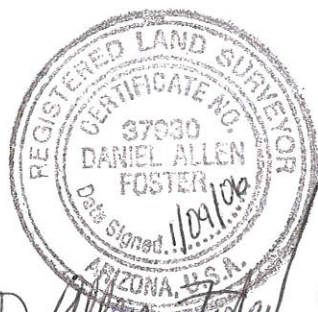

D. Allen Foster

(Seal)

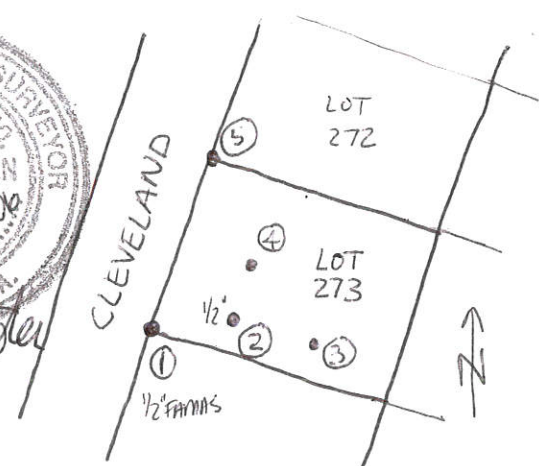

D. Allen Foster
Signed
FOSTCO SURVEYING INC.
Company Name
P.O. Box 4363
Address
CHINO VALLEY, AZ 86323
Telephone 928-636-9184

FOR YAVAPAI COUNTY FLOOD CONTROL DISTRICT USE:

Date: _____

Base Flood Elevation 4420.0' + 1.0' = Regulatory Elevation 4421.0'

* ELEVATION DETERMINATIONS ARE BASED ON BEST AVAILABLE DATA WHEN CALCULATED.
ELEVATIONS ARE SUBJECT TO CHANGE WHEN NEW OR REVISED FLOOD STUDIES OR DATA IS
SUPPLIED TO THE DISTRICT.