

FEDERAL EMERGENCY MANAGEMENT AGENCY
NATIONAL FLOOD INSURANCE PROGRAM

O.M.B. No. 3067-0077
Expires July 31, 2002

ELEVATION CERTIFICATE

Important: Read the instructions on pages 1 - 7.

SECTION A - PROPERTY OWNER INFORMATION

For Insurance Company Use:

Policy Number

Company NAIC Number

BUILDING OWNER'S NAME

1st American Title Agency

BUILDING STREET ADDRESS (Including Apt., Unit, Suite, and/or Bldg. No.) OR P.O. ROUTE AND BOX NO.

24260 N. Bourbon Alley

CITY

STATE

AZ

ZIP CODE

PROPERTY DESCRIPTION (Lot and Block Numbers, Tax Parcel Number, Legal Description, etc.)

APN 304-07-313

BUILDING USE (e.g., Residential, Non-residential, Addition, Accessory, etc. Use Comments section if necessary.)

New Residential

LATITUDE/LONGITUDE (OPTIONAL)

(##°-##'-##" or ##.#####)

HORIZONTAL DATUM:

NAD 1927 NAD 1983

SOURCE: GPS (Type):

USGS Quad Map Other:

SECTION B - FLOOD INSURANCE RATE MAP (FIRM) INFORMATION

B1. NFIP COMMUNITY NAME & COMMUNITY NUMBER

Yavapai Co. 040093

B2. COUNTY NAME

YAVAPAI

B3. STATE

AZ

B4. MAP AND PANEL NUMBER

04025C0990

B5. SUFFIX

F

B6. FIRM INDEX DATE

6-6-01

B7. FIRM PANEL EFFECTIVE/REVISED DATE

6-6-01

B8. FLOOD ZONE(S)

AE

B9. BASE FLOOD ELEVATION(S) (Zone AE, use depth of flooding)

4404.2'

B10. Indicate the source of the Base Flood Elevation (BFE) data or base flood depth entered in B9.

FIS Profile FIRM Community Determined Other (Describe):

B11. Indicate the elevation datum used for the BFE in B9: NGVD 1929 NAVD 1988 Other (Describe):

B12. Is the building located in a Coastal Barrier Resources System (CBRS) area or Otherwise Protected Area (OPA)? Yes No
Designation Date:

SECTION C - BUILDING ELEVATION INFORMATION (SURVEY REQUIRED)

C1. Building elevations are based on: Construction Drawings* Building Under Construction* Finished Construction

*A new Elevation Certificate will be required when construction of the building is complete.

C2. Building Diagram Number B (Select the building diagram most similar to the building for which this certificate is being completed - see pages 6 and 7. If no diagram accurately represents the building, provide a sketch or photograph.)


C3. Elevations - Zones A1-A30, AE, AH, A (with BFE), VE, V1-V30, V (with BFE), AR, AR/A, AR/AE, AR/A1-A30, AR/AH, AR/AO
Complete Items C3a-i below according to the building diagram specified in Item C2. State the datum used. If the datum is different from the datum used for the BFE in Section B, convert the datum to that used for the BFE. Show field measurements and datum conversion calculation. Use the space provided or the Comments area of Section D or Section G, as appropriate, to document the datum conversion.

Datum NGVD 29' Conversion/Comments

Elevation reference mark used RM23 / ERM 4-15 Does the elevation reference mark used appear on the FIRM? Yes No

- a) Top of bottom floor (including basement or enclosure) 4403 . 30 ft.(m)
- b) Top of next higher floor 4409. . 07 ft.(m)
- c) Bottom of lowest horizontal structural member (V zones only) 4407. . 57 ft.(m)
- d) Attached garage (top of slab) N/A . ft.(m)
- e) Lowest elevation of machinery and/or equipment servicing the building N/A . ft.(m)
- f) Lowest adjacent grade (LAG) 4403 . 30 ft.(m)
- g) Highest adjacent grade (HAG) 4403 . 65 ft.(m)
- h) No. of permanent openings (flood vents) within 1 ft. above adjacent grade 2
- i) Total area of all permanent openings (flood vents) in C3h ± 1368 sq. in. (sq. cm)

License Number, Embossed Seal, Signature, and Date

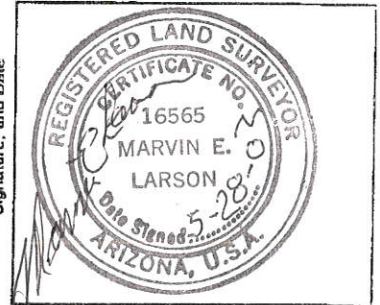

SECTION D - SURVEYOR, ENGINEER, OR ARCHITECT CERTIFICATION

This certification is to be signed and sealed by a land surveyor, engineer, or architect authorized by law to certify elevation information.

I certify that the information in Sections A, B, and C on this certificate represents my best efforts to interpret the data available.

I understand that any false statement may be punishable by fine or imprisonment under 18 U.S. Code, Section 1001.

CERTIFIER'S NAME

MARVIN E. LARSON

LICENSE NUMBER

L.S. 16565

TITLE

P.E., R.L.S.

COMPANY NAME

SUNDIAL ENGINEERING

ADDRESS

3500 WILLOW CREEK RD.

CITY

PRESCOTT

STATE

AZ

ZIP CODE

86305

SIGNATURE

Marvin E. Larson

DATE

5-28-02

TELEPHONE

(928) 445-2454

IMPORTANT: In these spaces, copy the corresponding information from Section A.

BUILDING STREET ADDRESS (Including Apt., Unit, Suite, and/or Bldg. No.) OR P.O. ROUTE AND BOX NO. 24260 N BOURBON AVE		For Insurance Company Use: Policy Number
CITY PAULDEN	STATE AZ	Company NAIC Number

SECTION D - SURVEYOR, ENGINEER, OR ARCHITECT CERTIFICATION (CONTINUED)

Copy both sides of this Elevation Certificate for (1) community official, (2) insurance agent/company, and (3) building owner.

COMMENTS **ELEVATION OF C30C IS TO THE BOTTOM OF THE STRUCTURAL FRAME OF A MANUFACTURED HOME. HOME IS ELEVATED, WITH WOOD SKIRTING AND CONTAINS 2 FLOOD VENTS.**

Check here if attachments

SECTION E - BUILDING ELEVATION INFORMATION (SURVEY NOT REQUIRED) FOR ZONE AO AND ZONE A (WITHOUT BFE)

For Zone AO and Zone A (without BFE), complete Items E1 through E4. If the Elevation Certificate is intended for use as supporting information for a LCMA or LOMR-F, Section C must be completed.

- Building Diagram Number ____ (Select the building diagram most similar to the building for which this certificate is being completed - see pages 6 and 7. If no diagram accurately represents the building, provide a sketch or photograph.)
- The top of the bottom floor (including basement or enclosure) of the building is ____ ft.(m) ____ in.(cm) above or below (check one) the highest adjacent grade.
- For Building Diagrams 6-8 with openings (see page 7), the next higher floor or elevated floor (elevation b) of the building is ____ ft.(m) ____ in.(cm) above the highest adjacent grade.
- For Zone AO only: If no flood depth number is available, is the top of the bottom floor elevated in accordance with the community's floodplain management ordinance? Yes No Unknown. The local official must certify this information in Section G.

SECTION F - PROPERTY OWNER (OR OWNER'S REPRESENTATIVE) CERTIFICATION

The property owner or owner's authorized representative who completes Sections A, B, and E for Zone A (without a FEMA-issued or community-issued BFE) or Zone AO must sign here.

PROPERTY OWNER'S OR OWNER'S AUTHORIZED REPRESENTATIVE'S NAME _____

ADDRESS _____	CITY _____	STATE _____	ZIP CODE _____
SIGNATURE _____	DATE _____	TELEPHONE _____	

COMMENTS _____

Check here if attachments

SECTION G - COMMUNITY INFORMATION (OPTIONAL)

The local official who is authorized by law or ordinance to administer the community's floodplain management ordinance can complete sections A, B, C (or E), and G of this Elevation Certificate. Complete the applicable item(s) and sign below.

- The information in Section C was taken from other documentation that has been signed and embossed by a licensed surveyor, engineer, or architect who is authorized by state or local law to certify elevation information. (Indicate the source and date of the elevation data in the Comments area below.)
- A community official completed Section E for a building located in Zone A (without a FEMA-issued or community-issued BFE) or Zone AO.
- The following information (Items G4-G9) is provided for community floodplain management purposes.

G4. PERMIT NUMBER _____	G5. DATE PERMIT ISSUED _____	G6. DATE CERTIFICATE OF COMPLIANCE/OCCUPANCY ISSUED _____
-------------------------	------------------------------	---

7. This permit has been issued for: New Construction Substantial Improvement

8. Elevation of as-built lowest floor (including basement) of the building is: _____ ft.(m) Datum: _____

9. BFE or (in Zone AO) depth of flooding at the building site is: _____ ft.(m) Datum: _____

LOCAL OFFICIAL'S NAME _____	TITLE _____
COMMUNITY NAME _____	TELEPHONE _____
SIGNATURE _____	DATE _____

COMMENTS _____

Check here if attachments

ELEVATION OF FLOODPLAIN PROPERTY

When Completed Return To: Yavapai County Development Services - Floodplain Unit
 500 S. Marina St., Prescott, AZ, 86303 (928) 771-3197 FAX 771-3427

DATE 2/20/02

ASSESSOR'S PARCEL NUMBER 304-07-313

SUBDIVISION NAME UNIT/PHASE AND LOT NUMBER SUNSET MOBILE SITES LOT 313

OWNER 1ST AMERICAN TITLE INS. AGENCY

SITUS ADDRESS _____

BASE BENCHMARK: Number RM 23 (ERM-1415) Elevation 4400.46'


PROPERTY BENCHMARK SOUTHWEST PROPERTY CORNER 1/2" FEMAS REBAR (4399.81)

DESCRIPTION OF PROPERTY BENCHMARK 1/2" REBAR ELEV = (4403.26')

GROUND ELEVATIONS AT BUILDING SITE NE PAD = 4402.72' NW PAD = 4402.36' SE PAD = 4403.30'
 (Please provide a minimum of three (3) elevations points, representative of the site)

Sketch of Lot
 (include location of property benchmark and building site elevations)

Remarks _____

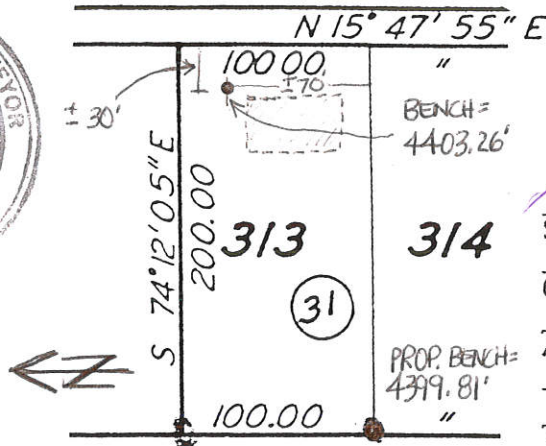

Marvin Larson
 Signed _____
 Company Name SUNDIAL ENGINEERING
 Address 3500 WILLOW CREEK RD
PRESCOTT, AZ 86305
 Telephone (928) 445-2454

FOR YAVAPAI COUNTY FLOOD CONTROL DISTRICT USE:

Date: _____

Base Flood Elevation 4403.2 + 1.0' = Regulatory Elevation 4404.2

* ELEVATION DETERMINATIONS ARE BASED ON BEST AVAILABLE DATA WHEN CALCULATED. ELEVATIONS ARE SUBJECT TO CHANGE WHEN NEW OR REVISED FLOOD STUDIES OR DATA IS SUPPLIED TO THE DISTRICT.