

PA. Copy

OMB No. 1660-0008 Expires February 28, 2009

U.S. DEPARTMENT OF HOMELAND SECURITY Federal Emergency Management Agency National Flood Insurance Program

ELEVATION CERTIFICATE

Important: Read the instructions on pages 1-8.

SECTION A - PROPERTY INFORMATION. A1. Building Owner's Name: DAVID & DEBRA SCHIFFLEA. A2. Building Street Address: 475 E. PITTSBURGH, City: PAULDEN, AZ, State: AZ, ZIP Code: 86334. A3. Property Description: APN 304-07-326, LOT 326 SUNSET MOBILE SITES. A4. Building Use: RESIDENTIAL. A5. Latitude/Longitude: Lat 34° 53' 51.82" N, Long 112° 27' 43.11" W. A6. Attach at least 2 photographs of the building. A7. Building Diagram Number: A. A8. For a building with a crawl space or enclosure(s), provide: a) Square footage of crawl space or enclosure(s): 13000 sq ft. b) No. of permanent flood openings in the crawl space or enclosure(s) walls within 1.0 foot above adjacent grade: 2. c) Total net area of flood openings in A8.b: 12440 sq in. A9. For a building with an attached garage, provide: a) Square footage of attached garage: N/A sq ft. b) No. of permanent flood openings in the attached garage walls within 1.0 foot above adjacent grade: N/A. c) Total net area of flood openings in A9.b: N/A sq in.

SECTION B - FLOOD INSURANCE RATE MAP (FIRM) INFORMATION. B1. NFIP Community Name & Community Number: YAVAPAI COUNTY 040093. B2. County Name: YAVAPAI. B3. State: AZ. B4. Map/Panel Number: 04025C0990. B5. Suffix: F. B6. FIRM Index Date: 6-6-01. B7. FIRM Panel Effective/Revised Date: 6-6-01. B8. Flood Zone(s): AE. B9. Base Flood Elevation(s) (Zone AO, use base flood depth): 4409.00. B10. Indicate the source of the Base Flood Elevation (BFE) data or base flood depth entered in Item B9: FIS Profile, FIRM, Community Determined, Other (Describe). B11. Indicate elevation datum used for BFE in Item B9: NAVD 1929, NAVD 1985, Other (Describe). B12. Is the building located in a Coastal Barrier Resources System (CBRS) area or Otherwise Protected Area (OPA)? Designation Date: No.

SECTION C - BUILDING ELEVATION INFORMATION (SURVEY REQUIRED). C1. Building elevations are based on: Construction Drawings, Building Under Construction, Finished Construction. C2. Elevations - Zones A1-A30, AE, AH, A (with BFE), VE, V1-V30, V (with BFE), AR, AR/A, AR/AE, AR/A1-A30, AR/AH, AR/AO. Complete items C2.a-g below according to the building diagram specified in item A7. Benchmark Utilized: RM 23 (BIRM 415). Vertical Datum: ELEV = 4400.46'. Conversion/Comments: Check the measurement used. a) Top of bottom floor (including basement, crawl space, or enclosure floor): 4410.75 feet. b) Top of the next higher floor: 4413.73 feet. c) Bottom of the lowest horizontal structural member (V Zones only): N/A feet. d) Attached garage (top of slab): N/A feet. e) Lowest elevation of machinery or equipment servicing the building (Describe type of equipment in Comments): 4410.82 feet. f) Lowest adjacent (finished) grade (LAG): 4410.55 feet. g) Highest adjacent (finished) grade (HAG): 4411.08 feet.

SECTION D - SURVEYOR, ENGINEER, OR ARCHITECT CERTIFICATION. This certification is to be signed and sealed by a land surveyor, engineer, or architect authorized by law to certify elevation information. I certify that the information on this Certificate represents my best efforts to interpret the data available. I understand that any false statement may be punishable by fine or imprisonment under 18 U.S. Code, Section 1001. [X] Check here if comments are provided on back of form. Certifier's Name: D. Allen Foster, Owner. Title: P.O. Box 4363. Address: D. Allen Foster. Signature: D. Allen Foster. License Number: RLS #37930. Company Name: FOSTER SURVEYING. City: CHINO VALLEY, AZ. State: AZ. ZIP Code: 86323. Date: 12/13/06. Telephone: 928-636-9196.



IMPORTANT: In these spaces, copy the corresponding information from Section A.

Building Street Address (including Apt., Unit, Suite, and/or Bldg. No.) or P.O. Route and Box No.

475 E. PITTSBURGH

City

PAULDEN

State

AZ

ZIP Code

8554

For Insurance Company Use:

Policy Number:

Company NAIC Number:

SECTION D - SURVEYOR, ENGINEER, OR ARCHITECT CERTIFICATION (CONTINUED)

Copy both sides of this Elevation Certificate for (1) community official, (2) insurance agent/company, and (3) building owner.

Comments

HOME IS A MANUFACTURED DEL-WIDE MOBILE ON A BLOCK FOUNDATION IN A BUILT-UP PAD THAT IS 3.0 HIGH. ELEVATION OF THE LOWEST STRUCTURE FLOOR IS 411.93, AND THE LOWEST DIMENSION IS AN HP'S PEDestal. THE FLOOD VENTS SHOWN ARE 5" FROM GROUND.

Signature

D. Allen Tate

Date

12/14/06

Check here if attachments

SECTION E - BUILDING ELEVATION INFORMATION (SURVEY NOT REQUIRED) FOR ZONE AO AND ZONE A (WITHOUT BFE)

For Zones AO and A (without BFE), complete items E1-E5. If the Certificate is intended to support a LOMA or LOMR-F request, complete Sections A, B, and C. For items E1-E4, use natural grade, if available. Check the measurement used in Puerto Rico only, enter meters.

E1. Provide elevation information for the following and check the appropriate boxes to show whether the elevation is above or below the highest adjacent grade (HAG) and the lowest adjacent grade (LAG).

a) Top of bottom floor (including basement, crawl space, or enclosure) is _____ feet _____ meters _____ above or _____ below the HAG.

b) Top of bottom floor (including basement, crawl space, or enclosure) is _____ feet _____ meters _____ above or _____ below the LAG.

E2. For Building Diagrams 6-8 with permanent flood openings provided in Section A Items 8 and/or 9 (see page 8 of instructions), the next higher floor (elevation GR.b in the diagrams) of the building is _____ feet _____ meters _____ above or _____ below the HAG.

E3. Attached garage (top of slab) is _____ feet _____ meters _____ above or _____ below the HAG.

E4. Top of platform of machinery and/or equipment servicing the building is _____ feet _____ meters _____ above or _____ below the HAG.

E5. Zone AO only: If no flood depth number is available, is the top of the bottom floor elevated in accordance with the community's floodplain management ordinance? Yes No Unknown. The local official must certify this information in Section G.

SECTION F - PROPERTY OWNER (OR OWNER'S REPRESENTATIVE) CERTIFICATION

The property owner or owner's authorized representative who completes Sections A, B, and E for Zone A (without a FEMA-issued or community-issued BFE) or Zone AO must sign here. The statements in Sections A, B, and E are correct to the best of my knowledge.

Property Owner's or Owner's Authorized Representative's Name

Address

City

State

ZIP Code

Signature

Date

Telephone

Comments

Check here if attachments

SECTION G - COMMUNITY INFORMATION (OPTIONAL)

The local official who is authorized by law or ordinance to administer the community's floodplain management ordinance can complete Sections A, B, C (or E), and G of this Elevation Certificate. Complete the applicable item(s) and sign below. Check the measurement used in items G8 and G9.

G1. The information in Section C was taken from other documentation that has been signed and sealed by a licensed surveyor, engineer, or architect who is authorized by law to certify elevation information. (Indicate the source and date of the elevation data in the Comments area below.)

G2. A community official completed Section E for a building located in Zone A (without a FEMA-issued or community-issued BFE) or Zone AO.

G3. The following information (Items G4-G9) is provided for community floodplain management purposes.

G4. Permit Number

MOG-43

G5. Date Permit issued

10-19-06

G6. Date Certificate Of Compliance/Occupancy issued

G7. This permit has been issued for: New Construction Substantial Improvement

G8. Elevation of as-built lowest floor (including basement) of the building: _____ feet _____ meters (PR) Datum _____

G9. BFE or (in Zone AO) depth of flooding at the building site: _____ feet _____ meters (PR) Datum _____

Local Official's Name

Title

Community Name

Telephone

Signature

Date

Comments

Check here if attachments



02.26.2007

West side

(60)(24)(2) = 2880 #



02.26.2007

East side

ELEVATION OF FLOODPLAIN PROPERTY

When Completed Return To: Yavapai County Development Services - Floodplain Unit
500 S. Marina St., Prescott, AZ, 86303 (928) 771-3197 FAX 771-3427

DATE 10/09/06

ASSESSOR'S PARCEL NUMBER 304-07-326

SUBDIVISION NAME UNITY/PHASE AND LOT NUMBER SUNSET MOBILE SITES LOT 326

OWNER JEL DONNELLY

SITUS ADDRESS _____

BASE BENCHMARK: Number BM 23 (EEM #15) Elevation 4400.96'



PROPERTY BENCHMARK ① 4407.71' ② 4407.51'

DESCRIPTION OF PROPERTY BENCHMARK ① 1/2" PAVES @ NW PROP. COR.
② 1/2" REBAR ± 0.20 ABOVE GROUND

GROUND ELEVATIONS AT BUILDING SITE ③ 4407.48' ④ 4407.60' ⑤ 4407.53'
(Please provide a minimum of three (3) elevations points, representative of the site)

Sketch of Lot
(include location of property benchmark and building site elevations)

Remarks LOT IS RELATIVELY FLAT.
NO PAD EXISTING. SHOTS TAKEN
AT GROUND. DIRT BIRM BUILT UP
ON EAST LOT LINE.

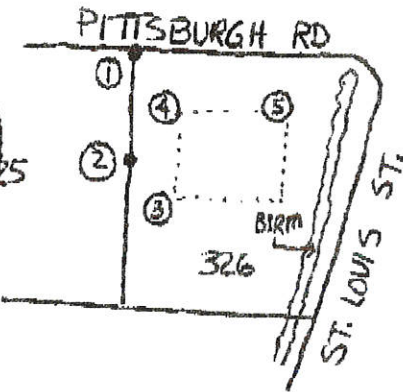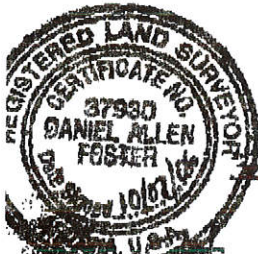

Signed D. Allen Foster
Company Name FOSTER SURVEYING
Address P.O. BOX 4363
CHINO VALLEY, AZ 86323
Telephone 928-636-9184

FOR YAVAPAI COUNTY FLOOD CONTROL DISTRICT USE:

Base Flood Elevation 4409.8 + 1.0' = Regulatory Elevation 4410.8 ft Date: 10/17/06

* ELEVATION DETERMINATIONS ARE BASED ON BEST AVAILABLE DATA WHEN CALCULATED. ELEVATIONS ARE SUBJECT TO CHANGE WHEN NEW OR REVISED FLOOD STUDIES OR DATA IS SUPPLIED TO THE DISTRICT.