FEDERAL EMERGENCY MANAGEMENT AGENCY NATIONAL FLOOD INSURANCE PROGRAM

ELEVATION CERTIFICATE

O.M.B. No. 3067-0077 Expires December 31, 2005

Important: Read the instructions on pages 1 - 7.

		SECTION	A - PROPER	RTY OWNE	R INFORMA	ATION		For Insurance Company Use:	
BUILDING OWNER'S NAME						-	Policy Number		
MICHAEL OR DEBORAH JEFFREY							3		
BUILDING STREET ADDRESS (Including Apt., Unit, Suite, and/or Bldg. No.) OR P.O. ROUTE AND BOX NO. 25250 N. CEDAR DRIVE					SOX NO.		Company NAIC Number		
CITY PAULDEN				STAT	E		CODE		
PROPERTY DESCRIPTI	ON (Lot and Bloc	k Numbers Tay Parce	l Number Le	AZ and Descrir	otion oto)	863	34		
APN 305-03-198D	LOTS 198 &	199 ANTELOPE L	AKES UNIT	2, SEC. 2	27, T18N, F	R2W, G&SRB&M,			
BUILDING USE (e.g., Re	sidential, Non-resi	dential, Addition, Acce	ssory, etc. U	lse a Comn	nents area, if	necessary.)			
RESIDENTIAL LATITUDE/LONGITUDE	(ODTIONAL)	LIODIZ							
(##°-##-##.##" or ##		HORIZ □ NAD 19	ONTAL DAT 27 🔲 NA			SOURCE: GPS (USGS	Type): Quad IV	lap Other:	
		SECTION B - FLOOI	OINSURAN	CE RATE I	/IAP (FIRM) I	INFORMATION			
B1. NFIP COMMUNITY NAME	& COMMUNITY NUM	MBER	B2. COUNTY	B2. COUNTY NAME			B3. STA	ATE	
YAVAPAI COUNTY 04	10093		YAVAPAI COUNTY				100000000000000000000000000000000000000	ARIZONA	
B4. MAP AND PANEL				B7. FIRM P	ANEL		I R	9. BASE FLOOD ELEVATION(S)	
NUMBER 04025C0990	B5. SUFFIX F	B6. FIRM INDEX DATE 06-06-01	E EFF 06-06-	ECTIVE/REV		B8. FLOOD ZONE(S		(Zone AO, use depth of flooding) 4460.1	
B10. Indicate the source of the	Base Flood Elevation			red in B9.					
	⊠ FIRM	Community De	termined		Other (Desc				
B11. Indicate the elevation datu				[NAVD 1988	Other (Describe):			
B12. Is the building located in a							o Desig	gnation Date	
01.5 ***		CTION C - BUILDING		35 35 35 35 35 35 35 35 35 35 35 35 35 3	THE RESERVE TO THE PERSON NAMED IN	RVEY REQUIRED)			
C1. Building elevations are bas			Building Ur	nder Constru	ıction*	Finished Construction			
*A new Elevation Certificat	e will be required wh	nen construction of the b	uilding is comp	olete.					
C2. Building Diagram Number	8 (Select the build	ing diagram most similar	to the building	for which th	is certificate is l	being completed - see pa	ages 6 ar	nd 7. If no diagram	
accurately represents the t	ouilding, provide a sl	ketch or photograph.)							
C3. Elevations – Zones A1-A30	, AE, AH, A (with BI	FE), VE, V1-V30, V (with	BFE), AR, AF	RA, AR/AE, A	AR/A1-A30, AF	R/AH, AR/AO			
Complete Items C3a-i bel	ow according to the	building diagram specifi	ed in Item C2.	State the da	tum used. If the	e datum is different from t	the datun	n used for the BFE in	
Section B, convert the datu	m to that used for th	ne BFE. Show field meas	surements and	datum conv	ersion calculat	ion. Use the space provi	ided or th	e Comments area of	
Section D or Section G, as		ument the datum conver	sion.						
Datum Conversion		d 1 - 1 - 1 - 1				5.00		_)	
Elevation reference mark u	sea RIVI 24 Does t	ine elevation reference m						CO LAUD ON	
a) Top of bottom floorb) Top of next higher floor				4459.2 FT	XX.	PACE GROUND)		CEREV CANON	
		LIDED LIONE		4462.20 FT	(FINISHED	FLOOR)		College Son Park	
o c) Bottom of THE FRAMo d) Attached garage	E OF IVIANUFACT	URED HOME		.20 FT				27737	
o e) Lowest elevation of m	achinon, and/or oa	inment	Ţ	NA			4	DUANE FAMAS	
servicing the building							9	P AMAS	
o f) Lowest adjacent (finish		irrierits area)	1.5	<u>VA</u>				1 C. 9170	
o g) Highest adjacent (finis	, ,			458 FT			4	TAP GHED	
o h) No. of permanent oper		uithin 1 ft above adiasas	4 1010	1459.5 FT -				ONA U.S.A.	
o i) Total area of all permar	nent openings (floor	d vents) in C3. 0 sq. ir		=					
o ij rotal alca ol ali politial						0			
	SE	CTION D - SURVEY	OR, ENGINE	ER, OR AI	RCHITECT C	ERTIFICATION			
This certification is to be sign	ned and sealed b	by a land surveyor, en	gineer, or arc	hitect auth	orized by law	to certify elevation inf	formation	١.	
I certify that the information	in Sections A, B,	and C on this certifica	ate represent	s my best e	efforts to inter	pret the data available	Э.		
I understand that any false CERTIFIER'S NAME DUA	Statement may be	punishable by fine of	r imprisonme	nt under 18	U.S. Code, S				
CERTIFIERSTVAIVIE DUA	NE FAMAS KI	LS				LICENSE NUMBER A	Z REG	27737	
TITLE LAND SURVEY	OR	4.7 °	e sé la	COMPA	ANY NAME I	FAMAS LAND SU	IRVEY	ORS, INC	
ADDRESS			1	CITY		STATE	E	ZIP CODE	
PO BOX 4357				PRES	COTT	AZ		86302	
SIGNATURE		\ .	-	DATE			PHONE		
1 W	Olla	Jamo	\bigcirc	08/17/20	004		-717-28	844_	

Section C must be completed. E1. Building Diagram Number_(Select the building diagram most similar to the building for which this certificate is being completed – see represents the building, provide a sketch or photograph.) E2. The top of the bottom floor (including basement or enclosure) of the building isft.(m)in.(cm) above or below (check natural grade, if available). E3. For Building Diagrams 8-8 with openings (see page 7), the next higher floor or elevated floor (elevation b) of the building isft.(m)grade. Complete items C3.h and C3.i on front of form. E4. The top of the platform of machinery and/or equipment servicing the building isft.(m)in.(cm) above or below (check natural grade, if available). E5. For Zone AO only: If no flood depth number is available, is the top of the bottom floor elevated in accordance with the community's flo	Policy Number
SECTION D - SURVEYOR, ENGINEER, OR ARCHITECT CERTIFICATION (CONTRI Copy both sides of this Elevation Certificate for (1) community official, (2) insurance agent/company, and (3) building owner. COMMENTS MANUFACTURED HOME SET ON PIERS WITH SKIRTING NO VENTS ELEVATIONS BASED ON RM 24 WITH AN ELEVATION OF 4455.

























G7. This permit has been issued for: New Construction Substantial Improvement G8. Elevation of as-built lowest floor (including basement) of the building is:	
G8. Elevation of as-built lowest floor (including basement) of the building is:ft.(m)	F COMPLIANCE/OCCUPANCY ISSUED
G9. BFE or (in Zone AO) depth of flooding at the building site is:ft.(m)	Datum: Datum:
LOCAL OFFICIAL'S NAME TITLE	
COMMUNITY NAME TELEPHONE	
SIGNATURE DATE	
COMMENTS	

ELEVATION CERTIFICATE FEDET L EMERGENCY MANAGEMENT AS ENCY NA. ONAL FLOOD INSURANCE PROC. AM

O.M.B. No. 3067-0077 Expires July 31,1999

ATTENTION: Use of this certificate does not provide a waiver of the flood insurance purchase requirement. This form is used only to provide elevation information necessary to ensure compliance with applicable community floodplain management ordinances, to determine the proper insurance premium rate, and/or to support a request for a Letter of Map Amendment or Revision (LOMA or LOMR). You are not required to respond to this collection of information unless a valid OMB control number is displayed in the upper right corner of this form.

Instructions for completing this form can be found on the follo

	matructions for co	impleting th	us form can be found on th	e following pag	es.			
	FOR INSURANCE COMPANY USE							
BUILDING OWNERS NAME	POLICY NUMBER							
Eugene Harold Bennett STREET ADDRESS (Including Ap	nt Unit Suita and/or I	Olda Manalan M	OD DO DOUTE LITE DOWNER					
25240 Cedar Dr.	BER	COMPANY NAIC NUMBER						
OTHER DESCRIPTION (Lot and I	Block Numbers, etc.)							
Lot 198 & 199 Antelope La	akes #2, 305-03-1	98A						
CITY			S	TATE	ZIP CODE			
Paulden				AZ	86334			
S	ECTION B FLC	OOD INSUE	ANCE RATE MAP (FIRM	4) INFORMAT	TION			
Provide the following from th	e proper FIRM (S							
	PANEL NUMBER	3. SUFFIX	4. DATE OF FIRM INDEX	5. FIRM ZONE	6. BASE FLOOD ELEVATION			
040093	605	\mathbf{C}	3/9/99	A12	(in AO Zones, use depth) 4459.6			
7. Indicate the elevation datum	system used on the	FIRM for B	ase Flood Elevations (BFE)	X NGVD '29	Other (describe on book)			
8. For Zones A or V, where no	BFE is provided on	the FIRM, a	nd the community has establis	shed a BFE for the	uis building site indicate			
the community's BFE:		feet	NGVD (or other FIRM datum	n-see Section B,	Item 7).			
	SECTION	C BUILDI	NG ELEVATION INFORM	MATION				
1. Using the Elevation Certific	cate Instructions	indicate the	diagram number from the	diagrama form				
describes the subject build	ling's reference le	wol 5	diagram number nom the	ulagrams round	i on Pages 5 and 6 that best			
2. (a). FIRM Zones A1-A30, AI	E, AH, and A (With	BFE). The	top of the reference level floc	or from the selec	ted diagram is at an elevation			
of <u>4461.7</u> feet NGVI) (or other FIRM d	atum-see Se	ection B, Item 7).					
(b). FIRM Zones V1-V30, V	E, and V (with BFF	E). The botto	om of the lowest horizontal st	tructural membe	r of the reference level from			
the selected diagram, is	at an elevation of	feet N	IGVD (or other FIRM datum-	see Section B. I	tem 7).			
(c). FIRM Zone A (without B	the selected diagram, is at an elevation of feet NGVD (or other FIRM datum-see Section B, Item 7). (c). FIRM Zone A (without BFE). The floor used as the reference level from the selected diagram is feet above or							
below (check one) the	he highest grade a	diacent to th	e building					
(d). FIRM Zone AO. The floo	or used as the refe	rence level	from the coloated diagram is	£1				
one) the highest grade a	discent to the built	ding If no fl	and double selected diagram is	reet above	, or below (check			
lovel) clayated in second	ajacent to the built	uing. If no fic	ood depth number is availabl	e, is the building	j's lowest floor (reference			
level) elevated in accorda	ance with the com	munity's floo	dplain management ordinand	ce? Yes	No Unknown			
3. Indicate the elevation datum	system used in d	etermining th	ne above reference level elev	rations: X No	GVD '29 Other (describe			
under Comments on Page 2	$(NOTE: If the \epsilon)$	elevation dat	um used in measuring the el	evations is diffe	rent than that used on			
the FIRM (see Section B, Ite	em 7), then conve	rt the elevati	ons to the datum system use	d on the FIRM a	and show the conversion			
equation under Comments of	on Page 2.)							
I. Elevation reference mark us	ed appears on FIF	RM: X Ye	s No (See Instructions o	n Page 4)				
5. The reference level elevation	n is based on X	actual cor	estruction construction of	drawings				
(NOTE:) Use of construction	drawings is only	colid if the h	ildian data not set le	arawings	.			
(NOTE:) Use of construction drawings is only valid if the building does not yet have the reference level floor in place, in which case this certificate will only be valid for the building during the course of construction. A post-construction Elevation Certificate								
case this certificate will only	be valid for the bu	liaing auring	the course of construction.	A post-construc	tion Elevation Certificate			
will be required once construction is complete.)								
The elevation of the lowest g	rade immediately	adjacent to t	he building is: 4 5 5 8	. 7 feet NGV	D (or other FIRM datum-see			
Section B, Item 7).								
	SECTI	ON D COM	MMUNITY INFORMATIO	ON				
If the community official room	onsible for varif	~ h						
. If the community official responses the "lowest floor" as do	onside for verifyin	g building el	evations specifies that the refe	erence level indic	ated in Section C. Item 1			
is not the "lowest floor" as de	ined in the commu	unity's flood	plain management ordinance, t	the elevation of t	he building's "lowest			
floor" as defined by the ordina		1 .	feet NGVD (or other F	IRM datum-see	Section B, Item 7).			
. Date of the start of constructio	n or substantial imp	provement _	4/4/95 .					


SECTION E CERTIFICATION

This certification is to be signed by a land surveyor, engineer, or architect who is authorized by state or local law to certify elevation information when the elevation information for Zones A1–A30, AE, AH, A (with BFE),V1–V30,VE, and V (with BFE) is required. Community officials who are authorized by local law or ordinance to provide floodplain management information, may also sign the certification. In the case of Zones AO and A (without a FEMA or community issued BFE), a building official, a property owner, or an owner's representative may also sign the certification.

Reference level diagrams 6, 7 and 8 - Distinguishing Features—If the certifier is unable to certify to breakaway/non-breakaway wall, enclosure size, location of servicing equipment, area use, wall openings, or unfinished area Feature(s), then list the Feature(s) not included in the certification under Comments below. The diagram number, Section C, Item 1, must still be entered.

I certify that the information in Sections B and C on this certificate represents my best efforts to interpret the data available. I understand that any false statement may be punishable by fine or imprisonment under 18 U.S. Code, Section 1001.

CERTIFIER'S NAME		LICENSE NUMBER (or Affix Seal)						
Kenneth E. Spedding,								
TITLE	COMPANY NA	ME	7					
District Director				4				
ADDRESS	CITY		STATE	ZIP				
500 S. Marina St.	Prescott		ΑZ	86303				
SIGNATURE /		8 27/9	PHONE (520) 771-:					
Copies should be made of this Certificate f	for: 1) community officia	al, 2) insurance age	ent/company, and 3) building	g owner.				
COMMENTS:	7 1			- 0				
Structure is a manufactured ho	ome. Elevation (2a)	is to the bottom	of the structural frame.	1				

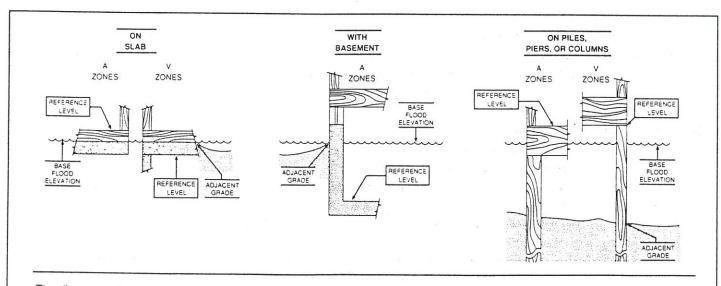

The diagrams above illustrate the points at which the elevations should be measured in A Zones and V Zones.

Elevations for all A Zones should be measured at the top of the reference level floor.

Elevations for all V Zones should be measured at the bottom of the lowest horizontal structural member.