

**ELEVATION CERTIFICATE**

Important: Read the instructions on pages 1 - 7.

**SECTION A - PROPERTY OWNER INFORMATION**

BUILDING OWNER'S NAME <i>Ligory + Deborah Krogh</i>		For Insurance Company Use: Policy Number
BUILDING STREET ADDRESS (Including Apt, Unit, Suite, and/or Bldg. No.) OR P.O. ROUTE AND BOX NO. <i>5130 E Haystack Rd</i>		Company NAIC Number
CITY	STATE	ZIP CODE

PROPERTY DESCRIPTION (Lot and Block Numbers, Tax Parcel Number, Legal Description, etc.)  
*APN 306-01-037#R*

BUILDING USE (e.g., Residential, Non-residential, Addition, Accessory, etc. Use Comments area if necessary.)  
*Residential*

LATITUDE/LONGITUDE (OPTIONAL) (##° - ##' - ##.###" or ##.#####°)      HORIZONTAL DATUM:  NAD 1927  NAD 1983      SOURCE:  GPS (Type): \_\_\_\_\_  
 USGS Quad Map  Other: \_\_\_\_\_

**SECTION B - FLOOD INSURANCE RATE MAP (FIRM) INFORMATION**

B1. NFIP COMMUNITY NAME & COMMUNITY NUMBER <i>Yavapai County 040093</i>		B2. COUNTY NAME <i>Yavapai</i>		B3. STATE <i>AZ</i>	
B4. MAP AND PANEL NUMBER <i>04025C1375 04025C1345</i>	B5. SUFFIX <i>F</i>	B6. FIRM INDEX DATE <i>6-6-01</i>	B7. FIRM PANEL EFFECTIVE/REVISED DATE <i>6-6-01</i>	B8. FLOOD ZONES <i>A</i>	B9. BASE FLOOD ELEVATION(S) <i>94.3 assumed per Aspen Creek Study</i>

B10. Indicate the source of the Base Flood Elevation (BFE) data or base flood depth entered in B9.  
 FIS Profile     FIRM     Community Determined     Other (Describe): *Aspen Creek Haystack Study*

B11. Indicate the elevation datum used for the BFE in B9:  NGVD 1929     NAVD 1988     Other (Describe): \_\_\_\_\_

B12. Is the building located in a Coastal Barrier Resources System (CBRS) area or Otherwise Protected Area (OPA)?  Yes  No  
 Designation Date: \_\_\_\_\_

**SECTION C - BUILDING ELEVATION INFORMATION (SURVEY REQUIRED)**

C1. Building elevations are based on:  Construction Drawings\*     Building Under Construction\*     Finished Construction  
 \*A new Elevation Certificate will be required when construction of the building is complete.


C2. Building Diagram Number 1 (Select the building diagram most similar to the building for which this certificate is being completed - see pages 6 and 7. If no diagram accurately represents the building, provide a sketch or photograph.)

C3. Elevations - Zones A1-A30, AE, AH, A (with BFE), VE, V1-V30, V (with BFE), AR, AR/A, AR/AE, AR/A1-A30, AR/AH, AR/AO  
 Complete Items C3.a-i below according to the building diagram specified in Item C2. State the datum used. If the datum is different from the datum used for the BFE in Section B, convert the datum to that used for the BFE. Show field measurements and datum conversion calculation. Use the space provided or the Comments area of Section D or Section G, as appropriate, to document the datum conversion.  
 Datum \_\_\_\_\_ Conversion/Comments \_\_\_\_\_

Elevation reference mark used NW COR. LOT 2B Does the elevation reference mark used appear on the FIRM?  Yes  No

- a) Top of bottom floor (including basement or enclosure) 110 . 63 ft. (m)
- b) Top of next higher floor N/A . \_\_\_\_\_ ft. (m)
- c) Bottom of lowest horizontal structural member (V zones only) N/A . \_\_\_\_\_ ft. (m)
- d) Attached garage (top of slab) 110 . 18 ft. (m)
- e) Lowest elevation of machinery and/or equipment servicing the building (Describe in a Comments area.) N/A . \_\_\_\_\_ ft. (m)
- f) Lowest adjacent (finished) grade (LAG) 105 . 71 ft. (m)
- g) Highest adjacent (finished) grade (HAG) 114 . 87 ft. (m)
- h) No. of permanent openings (flood vents) within 1 ft. above adjacent grade 0
- i) Total area of all permanent openings (flood vents) in C3.h 0 sq. in. (sq. cm)

License Number, Embossed Seal, Signature, and Date

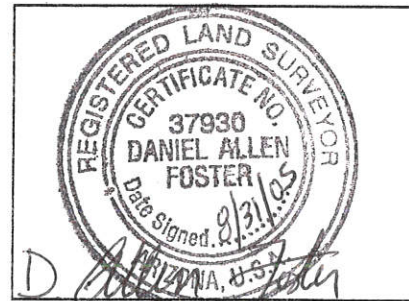

**SECTION D - SURVEYOR, ENGINEER, OR ARCHITECT CERTIFICATION**

This certification is to be signed and sealed by a land surveyor, engineer, or architect authorized by law to certify elevation information. I certify that the information in Sections A, B, and C on this certificate represents my best efforts to interpret the data available. I understand that any false statement may be punishable by fine or imprisonment under 18 U.S. Code, Section 1001.

CERTIFIER'S NAME <i>D. ALLEN FOSTER</i>		LICENSE NUMBER <i>RLS # 37930</i>	
TITLE <i>OWNER</i>	COMPANY NAME <i>FOSTCO SURVEYING</i>		
ADDRESS <i>P.O. Box 4363</i>	CITY <i>CHINO VALLEY</i>	STATE <i>AZ</i>	ZIP CODE <i>86323</i>
SIGNATURE <i>D. Allen Foster</i>	DATE <i>8/31/05</i>	TELEPHONE <i>928-636-9184</i>	



ELEVATION OF FLOODPLAIN PROPERTY

When Completed Return To: Yavapai County Development Services - Floodplain Unit  
500 S. Marina St., Prescott, AZ, 86303 (928) 771-3197 FAX 771-3427

DATE 2/04/05

ASSESSOR'S PARCEL NUMBER 306-01-037 F

SUBDIVISION NAME UNIT/PHASE AND LOT NUMBER HAYSTACK RANCHES, AMENDED LOT 2B

OWNER TODD HOWELL

SITUS ADDRESS HAYSTACK ROAD

BASE BENCHMARK: Number NW COR. LOT #1 Elevation 125.30 (relative)



PROPERTY BENCHMARK BM-3 = 131.10'  
① NW CORNER LOT 2B = 99.90', ② PROP. BENCH = 100.70, ③ 97.77, ④ 101.81

DESCRIPTION OF PROPERTY BENCHMARKS ① 1/2" FOSTER, ②-④ 1/2" REBARS ± 0.20 ABOVE GROUND.

GROUND ELEVATIONS AT BUILDING SITE  
*(Please provide a minimum of three (3) elevations points, representative of the site.)*

Sketch of Lot  
*(include location of property benchmark and building site elevations)*

Remarks: THERE WAS NO CONSTRUCTED PADS. PROPERTY BENCHES ARE AT PROPOSED BUILDING SITES.

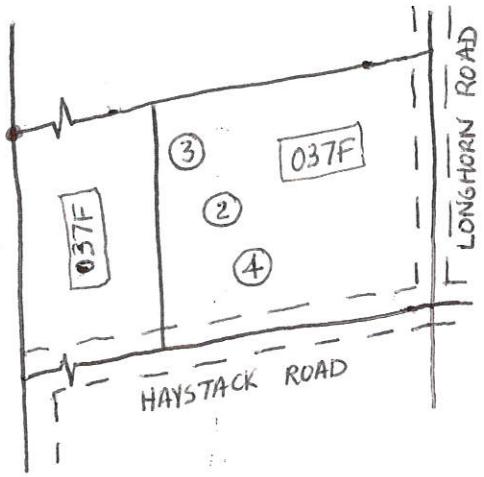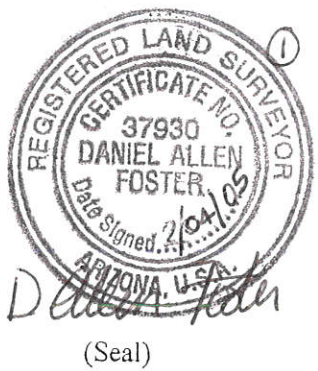

Signed D. Allen Foster  
FOSTCO SURVEYING  
Company Name  
P.O. Box 4363  
Address  
CHINO VALLEY, AZ 86323  
Telephone 928-636-9184

FOR YAVAPAI COUNTY FLOOD CONTROL DISTRICT USE: Date: \_\_\_\_\_

Base Flood Elevation \_\_\_\_\_ + 1.0' = Regulatory Elevation \_\_\_\_\_

\* ELEVATION DETERMINATIONS ARE BASED ON BEST AVAILABLE DATA WHEN CALCULATED. ELEVATIONS ARE SUBJECT TO CHANGE WHEN NEW OR REVISED FLOOD STUDIES OR DATA IS SUPPLIED TO THE DISTRICT.

## ELEVATION OF FLOODPLAIN PROPERTY

When Completed Return To: **Yavapai County Development Services – Floodplain Unit**  
 500 S. Marina St., Prescott, AZ, 86303 (928) 771-3197 FAX 771-3427

DATE 2/04/05

ASSESSOR'S PARCEL NUMBER 306-01-037F

SUBDIVISION NAME UNIT/PHASE AND LOT NUMBER HAYSTACK RANCHES AMENDED, LOT 2B

OWNER GREG KROG

SITUS ADDRESS HAYSTACK ROAD

BASE BENCHMARK: Number NW COR. LOT #1 Elevation 125.30 (relative)



PROPERTY BENCHMARK BM-3 = 131.10'  
 ① NW CORNER LOT 2B = 99.90', ② PROP. BENCH = 109.77

DESCRIPTION OF PROPERTY BENCHMARK ① 1/2" FOSTER, ② 1/2" REBAR APPROX 0.20'  
ABOVE GROUND.

GROUND ELEVATIONS AT BUILDING SITE ③ 109.80 ④ 109.85 ⑤ 109.65  
 (Please provide a minimum of three (3) elevations points, representative of the site)

Sketch of Lot  
 (include location of property benchmark and building site elevations)

Remarks BENCH IS LOCATED  
IN THE SW CORNER OF PAD.  
CENTER OF PAD IS ± 160' E. OF  
W. LINE AND ± 200' N. OF S. LINE.

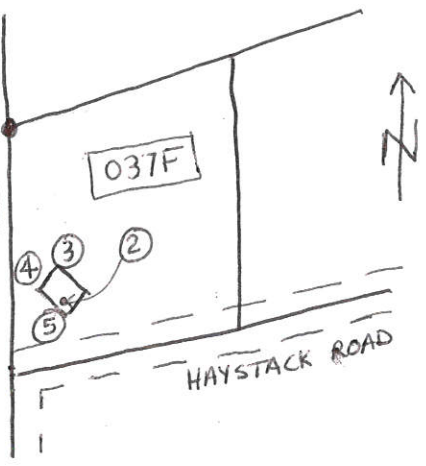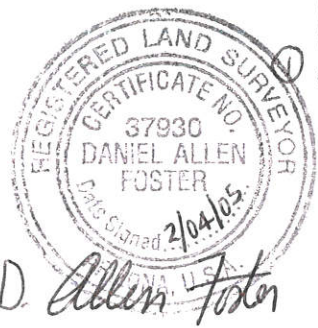

D. Allen Foster  
 Signed \_\_\_\_\_  
FOSTCO SURVEYING  
 Company Name \_\_\_\_\_  
P.O. BOX 4363  
 Address \_\_\_\_\_  
CHINO VALLEY, AZ 86323  
 Telephone 928-636-9184

FOR YAVAPAI COUNTY FLOOD CONTROL DISTRICT USE: Date: \_\_\_\_\_

Base Flood Elevation	+ 1.0' = Regulatory Elevation
----------------------	-------------------------------

*\* ELEVATION DETERMINATIONS ARE BASED ON BEST AVAILABLE DATA WHEN CALCULATED. ELEVATIONS ARE SUBJECT TO CHANGE WHEN NEW OR REVISED FLOOD STUDIES OR DATA IS SUPPLIED TO THE DISTRICT.*