

ELEVATION CERTIFICATE

Important: Read the instructions on pages 1 - 7.

SECTION A - PROPERTY OWNER INFORMATION

BUILDING OWNER'S NAME JAMES & CINDY HIGGINS		For Insurance Company Use: Policy Number	
BUILDING STREET ADDRESS (Including Apt., Unit, Suite, and/or Bldg. No.) OR P.O. ROUTE AND BOX NO. 2670 WILLOW BREEZE		Company NAIC Number	
CITY CHINO VALLEY	STATE AZ	ZIP CODE 86323	
PROPERTY DESCRIPTION (Lot and Block Numbers, Tax Parcel Number, Legal Description, etc.) APN # 306-02-510L			
BUILDING USE (e.g., Residential, Non-residential, Addition, Accessory, etc. Use Comments area if necessary.) RESIDENTIAL			
LATITUDE/LONGITUDE (OPTIONAL) (##" - ##" - ##.##" or ##.#####")		HORIZONTAL DATUM: SOURCE: <input type="checkbox"/> GPS (Type): <input type="checkbox"/> USGS Quad Map <input type="checkbox"/> Other:	
		<input type="checkbox"/> NAD 1927 <input type="checkbox"/> NAD 1983	

SECTION B - FLOOD INSURANCE RATE MAP (FIRM) INFORMATION

B1. NFIP COMMUNITY NAME & COMMUNITY NUMBER YAVAPAI COUNTY 040093		B2. COUNTY NAME YAVAPAI COUNTY		B3. STATE AZ	
B4. MAP AND PANEL NUMBER 04025C1705	B5. SUFFIX F	B6. FIRM INDEX DATE 6-06-01	B7. FIRM PANEL EFFECTIVE/REVISED DATE 6-06-01	B8. FLOOD ZONES AE	B9. BASE FLOOD ELEVATION(S) 4796.50

B10. Indicate the source of the Base Flood Elevation (BFE) data or base flood depth entered in B9.

FIS Profile FIRM Community Determined Other (Describe): **N/A**

B11. Indicate the elevation datum used for the BFE in B9: NGVD 1929 NAVD 1988 Other (Describe):

B12. Is the building located in a Coastal Barrier Resources System (CBRS) area or Otherwise Protected Area (OPA)? Yes No
Designation Date:


SECTION C - BUILDING ELEVATION INFORMATION (SURVEY REQUIRED)

C1. Building elevations are based on: Construction Drawings* Building Under Construction* Finished Construction
*A new Elevation Certificate will be required when construction of the building is complete.

C2. Building Diagram Number 1 (Select the building diagram most similar to the building for which this certificate is being completed - see pages 6 and 7. If no diagram accurately represents the building, provide a sketch or photograph.)

C3. Elevations - Zones A1-A30, AE, AH, A (with BFE), VE, V1-V30, V (with BFE), AR, AR/A, AR/AE, AR/A1-A30, AR/AH, AR/AO
Complete Items C3.a-i below according to the building diagram specified in Item C2. State the datum used. If the datum is different from the datum used for the BFE in Section B, convert the datum to that used for the BFE. Show field measurements and datum conversion calculation. Use the space provided or the Comments area of Section D or Section G, as appropriate, to document the datum conversion.
Datum _____ Conversion/Comments _____
Elevation reference mark used **RM 78** Does the elevation reference mark used appear on the FIRM? Yes No

<input type="checkbox"/> a) Top of bottom floor (including basement or enclosure)	4797.52 ft.(m)	License Number, Embossed Seal, Signature, and Date
<input type="checkbox"/> b) Top of next higher floor	N/A ft.(m)	
<input type="checkbox"/> c) Bottom of lowest horizontal structural member (V zones only)	N/A ft.(m)	
<input type="checkbox"/> d) Attached garage (top of slab)	4797.00 ft.(m)	
<input type="checkbox"/> e) Lowest elevation of machinery and/or equipment servicing the building (Describe in a Comments area.)	4796.70 ft.(m)	
<input type="checkbox"/> f) Lowest adjacent (finished) grade (LAG)	4795.29 ft.(m)	
<input type="checkbox"/> g) Highest adjacent (finished) grade (HAG)	4795.90 ft.(m)	
<input type="checkbox"/> h) No. of permanent openings (flood vents) within 1 ft. above adjacent grade	0	
<input type="checkbox"/> i) Total area of all permanent openings (flood vents) in C3.h	0 sq. in. (sq. cm)	

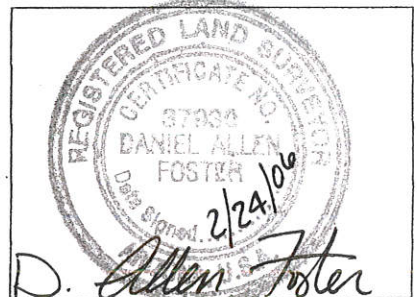

SECTION D - SURVEYOR, ENGINEER, OR ARCHITECT CERTIFICATION

This certification is to be signed and sealed by a land surveyor, engineer, or architect authorized by law to certify elevation information. I certify that the information in Sections A, B, and C on this certificate represents my best efforts to interpret the data available. I understand that any false statement may be punishable by fine or imprisonment under 18 U.S. Code, Section 1001.

CERTIFIER'S NAME D. ALLEN FOSTER		LICENSE NUMBER RLS # 37930	
TITLE OWNER	COMPANY NAME FOSTCO SURVEYING		
ADDRESS P.O. Box 4363	CITY CHINO VALLEY	STATE AZ	ZIP CODE 86323
SIGNATURE D. Allen Foster	DATE 2/24/06	TELEPHONE 928-636-9184	

X

IMPORTANT: In these spaces, copy the corresponding information from Section A.			For Insurance Company Use:
BUILDING STREET ADDRESS (Including Apt., Unit, Suite, and/or Bldg. No.) OR P.O. ROUTE AND BOX NO. 2670 WILLOW BREEZE			Policy Number
CITY	STATE	ZIP CODE	Company NAIC Number

SECTION D - SURVEYOR, ENGINEER, OR ARCHITECT CERTIFICATION (CONTINUED)

Copy both sides of this Elevation Certificate for (1) community official, (2) insurance agent/company, and (3) building owner.

COMMENTS

ELEVATION TO LOWEST MACHINERY, IS A PAD FOR AN A.C. UNIT THAT HAD NOT YET BEEN INSTALLED.

Check here if attachments

SECTION E - BUILDING ELEVATION INFORMATION (SURVEY NOT REQUIRED) FOR ZONE AO AND ZONE A (WITHOUT BFE)

For Zone AO and Zone A (without BFE), complete Items E1. through E4. If the Elevation Certificate is intended for use as supporting information for a LOMA or LOMR-F, Section C must be completed.

- E1. Building Diagram Number ____ (Select the building diagram most similar to the building for which this certificate is being completed - see pages 6 and 7. If no diagram accurately represents the building, provide a sketch or photograph.)
- E2. The top of the bottom floor (including basement or enclosure) of the building is ____ ft.(m) ____ in.(cm) ____ above or ____ below (check one) the highest adjacent grade. (Use natural grade, if available.)
- E3. For Building Diagrams 6-8 with openings (see page 7), the next higher floor or elevated floor (elevation b) of the building is ____ ft.(m) ____ in.(cm) above the highest adjacent grade. Complete Items C3.h and C3.i on front of form.
- E4. For Zone AO only: If no flood depth number is available, is the top of the bottom floor elevated in accordance with the community's floodplain management ordinance? Yes No Unknown. The local official must certify this information in Section G.

SECTION F - PROPERTY OWNER (OR OWNER'S REPRESENTATIVE) CERTIFICATION

The property owner or owner's authorized representative who completes Sections A, B, C (Items C3.h and C3.i only), and E for Zone A (without a FEMA-issued or community-issued BFE) or Zone AO must sign here. The statements in Sections A, B, C, and E are correct to the best of my knowledge.

PROPERTY OWNER'S OR OWNER'S AUTHORIZED REPRESENTATIVE'S NAME

ADDRESS CITY STATE ZIP CODE

SIGNATURE DATE TELEPHONE

COMMENTS

Check here if attachments

SECTION G - COMMUNITY INFORMATION (OPTIONAL)

The local official who is authorized by law or ordinance to administer the community's floodplain management ordinance can complete Sections A, B, C (or E), and G of this Elevation Certificate. Complete the applicable item(s) and sign below.

- G1. The information in Section C was taken from other documentation that has been signed and embossed by a licensed surveyor, engineer, or architect who is authorized by state or local law to certify elevation information. (Indicate the source and date of the elevation data in the Comments area below.)
- G2. A community official completed Section E for a building located in Zone A (without a FEMA-issued or community-issued BFE) or Zone AO.
- G3. The following information (Items G4-G9) is provided for community floodplain management purposes.

G4. PERMIT NUMBER	G5. DATE PERMIT ISSUED	G6. DATE CERTIFICATE OF COMPLIANCE/OCCUPANCY ISSUED
-------------------	------------------------	---

- G7. This permit has been issued for: New Construction Substantial Improvement
- G8. Elevation of as-built lowest floor (including basement) of the building is: _____ ft.(m) Datum: _____
- G9. BFE or (in Zone AO) depth of flooding at the building site is: _____ ft.(m) Datum: _____

LOCAL OFFICIAL'S NAME TITLE

COMMUNITY NAME TELEPHONE

SIGNATURE DATE

COMMENTS

Check here if attachments

ELEVATION OF FLOODPLAIN PROPERTY

When Completed Return To: Yavapai County Development Services – Floodplain Unit
500 S. Marina St., Prescott, AZ, 86303 (928) 771-3197 FAX 771-3427

DATE 10/28/05

ASSESSOR'S PARCEL NUMBER 306-02-510L

SUBDIVISION NAME UNIT/PHASE AND LOT NUMBER N/A SEC 29, T16N, R2W

OWNER JAMES & CINDY HIGGINS

SITUS ADDRESS WILLOW BREEZE ROAD

BASE BENCHMARK: Number B RM 78 Elevation 4808.67'


PROPERTY BENCHMARK ① 4797.05' , ② 4796.50'

DESCRIPTION OF PROPERTY BENCHMARK ① 1/2" 15666 @ NW. PROP. COR. ② 1/2" REBAR (BENCH)

GROUND ELEVATIONS AT BUILDING SITE ③ 4796.45' ④ 4796.38 ⑤ 4796.30'
(Please provide a minimum of three (3) elevations points, representative of the site)


Sketch of Lot
(include location of property benchmark and building site elevations)

Remarks _____

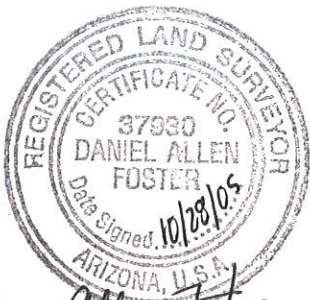

D. Allen Foster

(Seal)

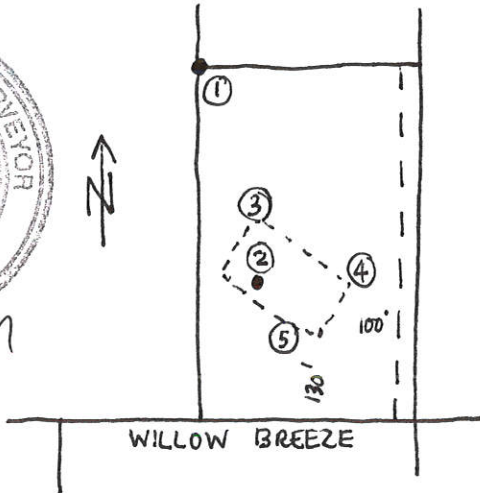

D. Allen Foster
Signed _____
FOSTCO SURVEYING
Company Name _____
P.O. BOX 4363
Address _____
CHINO VALLEY, AZ 86323
Telephone (928) 636-9184

FOR YAVAPAI COUNTY FLOOD CONTROL DISTRICT USE:

Date: _____

Base Flood Elevation + 1.0' = Regulatory Elevation

* ELEVATION DETERMINATIONS ARE BASED ON BEST AVAILABLE DATA WHEN CALCULATED. ELEVATIONS ARE SUBJECT TO CHANGE WHEN NEW OR REVISED FLOOD STUDIES OR DATA IS SUPPLIED TO THE DISTRICT.

ELEVATION OF FLOODPLAIN PROPERTY

When Completed Return To: YAVAPAI COUNTY DEVELOPMENT SERVICES – FLOODPLAIN UNIT

500 S. Marina St., Prescott, AZ, 86303 (928) 771-3197 FAX (928) 771-3427 Office: Prescott _____
10 S. 6th St., Cottonwood, AZ 86326 (928) 639-8151 FAX (928) 639-8118 Cottonwood _____

DATE 3-2-05

ASSESSOR'S PARCEL NUMBER 306-02-510F

SUBDIVISION NAME UNIT/PHASE AND LOT NUMBER _____

OWNER JOHN A. & MARY R. HUNT

SITUS ADDRESS WILLOW BREEZE RD CHINO VALLEY

BASE BENCHMARK: Number RM 78 Elevation 4808.67

PROPERTY BENCHMARK 4796.86

DESCRIPTION OF PROPERTY BENCHMARK TOP OF 1/2" REBAR AT NORTHWEST CORNER OF PROPOSED 2.14 ACRE PARCEL

GROUND ELEVATIONS AT BUILDING SITE 4796.86 - 4794.75 - 4795.01
(Please provide a minimum of three (3) elevation points, representative of the site)

Sketch of Lot
(include location of property benchmark and building site elevations)

Remarks _____

SEE ATTACHED

BUILDING AREA 2



(Seal)

Gary L. Berg
Signed _____

Company Name
1010 S. RD. 1 WEST

Address
CHINO VALLEY, AZ 86323

Telephone 636-2046



FOR YAVAPAI COUNTY FLOOD CONTROL DISTRICT USE:

Date: _____

Base Flood Elevation _____ + 1.0' = Regulatory Elevation

* ELEVATION DETERMINATIONS ARE BASED ON BEST AVAILABLE DATA WHEN CALCULATED. ELEVATIONS ARE SUBJECT TO CHANGE WHEN NEW OR REVISED FLOOD STUDIES OR DATA IS SUPPLIED TO THE DISTRICT.

PROPOSED BUILDING SITES WITHIN THE SW4 OF SEC. 29, T16N, R2W, G&SRM YAVAPAI COUNTY, AZ

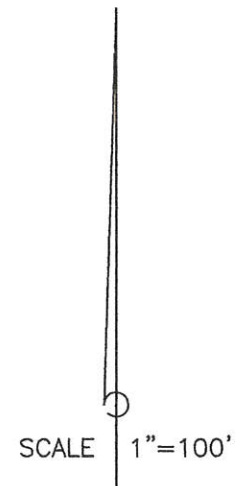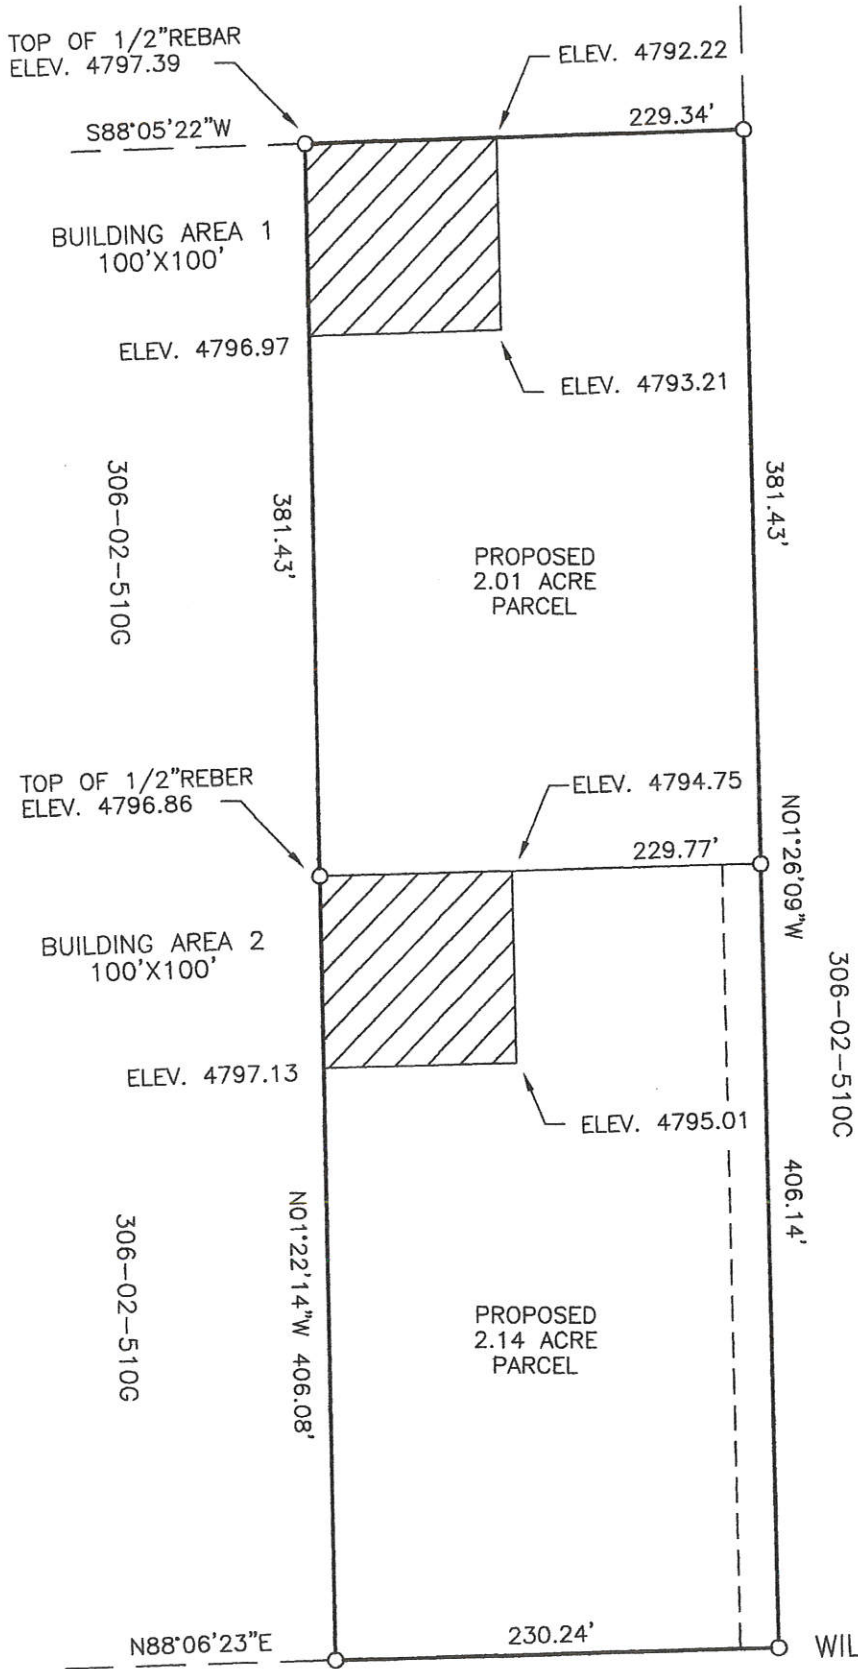

CURRENT A.P. NO. 306-02-510F
ELEVATIONS ARE BASED ON RM78
ELEVATION 4808.67 (PANEL 1750)

