

ELEVATION CERTIFICATE

Important: Read the instructions on pages 1 - 7.

SECTION A - PROPERTY OWNER INFORMATION

| | |
|---|---|
| BUILDING OWNER'S NAME <i>SYMICEK</i> | For Insurance Company Use: Policy Number |
| BUILDING STREET ADDRESS (Including Apt., Unit, Suite, and/or Bldg. No.) OR P.O. ROUTE AND BOX NO. <i>2650 Willow Blossom</i> | Company NAIC Number |
| CITY <i>Chino Valley</i> | STATE <i>AZ</i> |
| PROPERTY DESCRIPTION (Lot and Block Numbers, Tax Parcel Number, Legal Description, etc.) <i>APN 306-02-510M</i> | ZIP CODE <i>86323</i> |
| BUILDING USE (e.g., Residential, Non-residential, Addition, Accessory, etc. Use Comments area if necessary.) <i>Residential SB</i> | |

LATITUDE/LONGITUDE (OPTIONAL) _____ HORIZONTAL DATUM: NAD 1927 NAD 1983 SOURCE: GPS (Type): _____
(##° - ##' - ##.###" or ##.#####") USGS Quad Map Other: _____

SECTION B - FLOOD INSURANCE RATE MAP (FIRM) INFORMATION

| | | | | | |
|--|------------------------|--------------------------------------|--|------------------------------|---|
| B1. NFIP COMMUNITY NAME & COMMUNITY NUMBER <i>Yavapai County 040093</i> | | B2. COUNTY NAME <i>Yavapai</i> | | B3. STATE <i>AZ</i> | |
| B4. MAP AND PANEL NUMBER <i>04025C175D</i> | B5. SUFFIX <i>F</i> | B6. FIRM INDEX DATE <i>6-6-01</i> | B7. FIRM PANEL EFFECTIVE/REVISED DATE <i>6-6-01</i> | B8. FLOOD ZONES <i>AE</i> | B9. BASE FLOOD ELEVATION(S) <i>4790.65</i> |

B10. Indicate the source of the Base Flood Elevation (BFE) data or base flood depth entered in B9.
 FIS Profile FIRM Community Determined Other (Describe): _____

B11. Indicate the elevation datum used for the BFE in B9: NGVD 1929 NAVD 1988 Other (Describe): _____

B12. Is the building located in a Coastal Barrier Resources System (CBRS) area or Otherwise Protected Area (OPA)? Yes No
Designation Date: _____

SECTION C - BUILDING ELEVATION INFORMATION (SURVEY REQUIRED)


C1. Building elevations are based on: Construction Drawings* Building Under Construction* Finished Construction
*A new Elevation Certificate will be required when construction of the building is complete.

C2. Building Diagram Number 1 (Select the building diagram most similar to the building for which this certificate is being completed - see pages 6 and 7. If no diagram accurately represents the building, provide a sketch or photograph.)

C3. Elevations - Zones A1-A30, AE, AH, A (with BFE), VE, V1-V30, V (with BFE), AR, AR/A, AR/AE, AR/A1-A30, AR/AH, AR/AO
Complete items C3.a-i below according to the building diagram specified in item C2. State the datum used. If the datum is different from the datum used for the BFE in Section B, convert the datum to that used for the BFE. Show field measurements and datum conversion calculation. Use the space provided or the Comments area of Section D or Section G, as appropriate, to document the datum conversion.
Datum _____ Conversion/Comments _____
Elevation reference mark used RM 78 Does the elevation reference mark used appear on the FIRM? Yes No

| | | | |
|--|-------------|------------|------------------|
| <input type="checkbox"/> a) Top of bottom floor (including basement or enclosure) | <u>4793</u> | <u>.94</u> | ft.(m) |
| <input type="checkbox"/> b) Top of next higher floor | <u>NA</u> | | ft.(m) |
| <input type="checkbox"/> c) Bottom of lowest horizontal structural member (V zones only) | <u>NA</u> | | ft.(m) |
| <input type="checkbox"/> d) Attached garage (top of slab) | <u>4793</u> | <u>.31</u> | ft.(m) |
| <input type="checkbox"/> e) Lowest elevation of machinery and/or equipment servicing the building (Describe in a Comments area.) | <u>NA</u> | | ft.(m) |
| <input type="checkbox"/> f) Lowest adjacent (finished) grade (LAG) | <u>4792</u> | <u>.42</u> | ft.(m) |
| <input type="checkbox"/> g) Highest adjacent (finished) grade (HAG) | <u>4793</u> | <u>.51</u> | ft.(m) |
| <input type="checkbox"/> h) No. of permanent openings (flood vents) within 1 ft. above adjacent grade | <u>NA</u> | | |
| <input type="checkbox"/> i) Total area of all permanent openings (flood vents) in C3.h | <u>NA</u> | | sq. in. (sq. cm) |

License Number, Embossed Seal, Signature, and Date

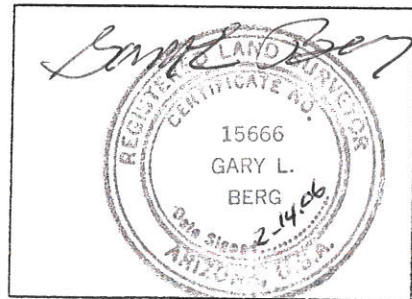

SECTION D - SURVEYOR, ENGINEER, OR ARCHITECT CERTIFICATION

This certification is to be signed and sealed by a land surveyor, engineer, or architect authorized by law to certify elevation information. I certify that the information in Sections A, B, and C on this certificate represents my best efforts to interpret the data available. I understand that any false statement may be punishable by fine or imprisonment under 18 U.S. Code, Section 1001.

CERTIFIER'S NAME GARY L. BERG LICENSE NUMBER 15666

TITLE LAND SURVEYOR COMPANY NAME _____

ADDRESS 1010 S. ROAD 1 W. CITY CHINO VALLEY STATE AZ ZIP CODE 86323

SIGNATURE [Signature] DATE 2-14-06 TELEPHONE 928-636-2046

| | | | |
|---|-------|----------|----------------------------|
| IMPORTANT: In these spaces, copy the corresponding information from Section A. | | | For Insurance Company Use: |
| BUILDING STREET ADDRESS (Including Apt., Unit, Suite, and/or Bldg. No.) OR P.O. ROUTE AND BOX NO. | | | Policy Number |
| CITY | STATE | ZIP CODE | Company NAIC Number |

SECTION D - SURVEYOR, ENGINEER, OR ARCHITECT CERTIFICATION (CONTINUED)

Copy both sides of this Elevation Certificate for (1) community official, (2) insurance agent/company, and (3) building owner.

COMMENTS

Check here if attachments

SECTION E - BUILDING ELEVATION INFORMATION (SURVEY NOT REQUIRED) FOR ZONE AO AND ZONE A (WITHOUT BFE)

For Zone AO and Zone A (without BFE), complete Items E1. through E4. If the Elevation Certificate is intended for use as supporting information for a LOMA or LOMR-F, Section C must be completed.

- E1. Building Diagram Number _____ (Select the building diagram most similar to the building for which this certificate is being completed - see pages 6 and 7. If no diagram accurately represents the building, provide a sketch or photograph.)
- E2. The top of the bottom floor (including basement or enclosure) of the building is _____ ft.(m) _____ in.(cm) _____ above or _____ below (check one) the highest adjacent grade. (Use natural grade, if available.)
- E3. For Building Diagrams 6-8 with openings (see page 7), the next higher floor or elevated floor (elevation b) of the building is _____ ft.(m) _____ in.(cm) above the highest adjacent grade.
- E4. The top of the platform of machinery and/or equipment servicing the building is _____ ft. (m) _____ in. (cm) _____ above or _____ below (check one) the highest adjacent grade. (Use natural grade, if available.)
- E5. For Zone AO only: If no flood depth number is available, is the top of the bottom floor elevated in accordance with the community's floodplain management ordinance? Yes No Unknown. The local official must certify this information in Section G.

SECTION F - PROPERTY OWNER (OR OWNER'S REPRESENTATIVE) CERTIFICATION

The property owner or owner's authorized representative who completes Sections A, B, C (Items C3.h and C3.i only), and E for Zone A (without a FEMA-issued or community-issued BFE) or Zone AO must sign here. The statements in Sections A, B, C, and E are correct to the best of my knowledge.

PROPERTY OWNER'S OR OWNER'S AUTHORIZED REPRESENTATIVE'S NAME

ADDRESS CITY STATE ZIP CODE

SIGNATURE DATE TELEPHONE

COMMENTS

Check here if attachments

SECTION G - COMMUNITY INFORMATION (OPTIONAL)

The local official who is authorized by law or ordinance to administer the community's floodplain management ordinance can complete Sections A, B, C (or E), and G of this Elevation Certificate. Complete the applicable item(s) and sign below.

- G1. The information in Section C was taken from other documentation that has been signed and embossed by a licensed surveyor, engineer, or architect who is authorized by state or local law to certify elevation information. (Indicate the source and date of the elevation data in the Comments area below.)
- G2. A community official completed Section E for a building located in Zone A (without a FEMA-issued or community-issued BFE) or Zone AO.
- G3. The following information (Items G4-G9) is provided for community floodplain management purposes.

| | | |
|-------------------|------------------------|---|
| G4. PERMIT NUMBER | G5. DATE PERMIT ISSUED | G6. DATE CERTIFICATE OF COMPLIANCE/OCCUPANCY ISSUED |
|-------------------|------------------------|---|

G7. This permit has been issued for: New Construction Substantial Improvement

G8. Elevation of as-built lowest floor (including basement) of the building is: _____ . _____ ft.(m) Datum: _____

G9. BFE or (in Zone AO) depth of flooding at the building site is: _____ . _____ ft.(m) Datum: _____

LOCAL OFFICIAL'S NAME TITLE

COMMUNITY NAME TELEPHONE

SIGNATURE DATE

COMMENTS

Check here if attachments

ELEVATION OF FLOODPLAIN PROPERTY

When Completed Return To: Yavapai County Development Services – Floodplain Unit
500 S. Marina St., Prescott, AZ, 86303 (928) 771-3197 FAX 771-3427

DATE 1/03/06

ASSESSOR'S PARCEL NUMBER 306-02-510P now 523C

SUBDIVISION NAME UNIT/PHASE AND LOT NUMBER _____

OWNER ROBERT BORDEN

SITUS ADDRESS WILLOW BREEZE

BASE BENCHMARK: Number RM 78 Elevation 4808.67



PROPERTY BENCHMARK ① EL = 4796.10'

DESCRIPTION OF PROPERTY BENCHMARK ① 1/2" FOSTER (4796.10'), ② 1/2" REBAR (4794.20')
⑤ 1/2" REBAR (4792.34'), ⑧ 1/2" REBAR (4790.27')

GROUND ELEVATIONS AT BUILDING SITE ③ 4794.01', ④ 4794.44', ⑥ 4792.20', ⑦ 4792.60', ⑨ 4790.10', ⑩ 4790.52'
(Please provide a minimum of three (3) elevations points, representative of the site)

Sketch of Lot
(include location of property benchmark and building site elevations)

Remarks PROPERTY HAS A
GRADUAL SLOPE TO THE NORTH. SET
BENCHES AT THREE POTENTIAL
BUILDING SITES.

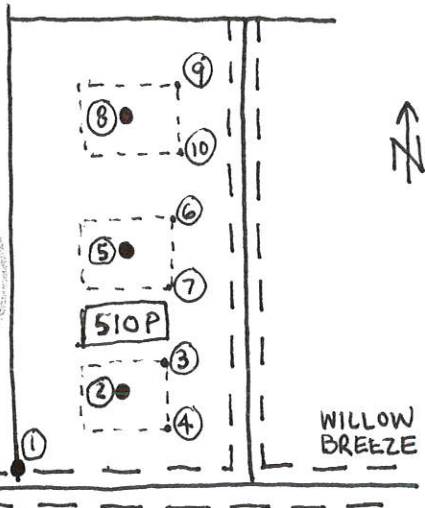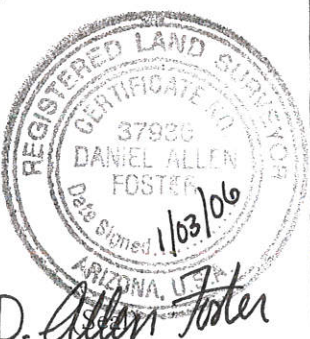

D. Allen Foster

Signed FOSTCO SURVEYING

Company Name P.O. Box 4363

Address CHINO VALLEY, AZ 86323

Telephone 928-636-9184

FOR YAVAPAI COUNTY FLOOD CONTROL DISTRICT USE:

Date: _____

Base Flood Elevation + 1.0' = Regulatory Elevation

* ELEVATION DETERMINATIONS ARE BASED ON BEST AVAILABLE DATA WHEN CALCULATED. ELEVATIONS ARE SUBJECT TO CHANGE WHEN NEW OR REVISED FLOOD STUDIES OR DATA IS SUPPLIED TO THE DISTRICT.

ELEVATION OF FLOODPLAIN PROPERTY

When Completed Return To: YAVAPAI COUNTY DEVELOPMENT SERVICES – FLOODPLAIN UNIT

500 S. Marina St., Prescott, AZ, 86303 (928) 771-3197 FAX (928) 771-3427 Office: Prescott _____
10 S. 6th St., Cottonwood, AZ 86326 (928) 639-8151 FAX (928) 639-8118 Cottonwood _____

DATE 3-2-05

ASSESSOR'S PARCEL NUMBER 306-02-510F (now 5280)

SUBDIVISION NAME UNIT/PHASE AND LOT NUMBER _____

OWNER JOHN A. & MARY R. HUNT

SITUS ADDRESS WILLOW BREEZE RD. CHINO VALLEY

BASE BENCHMARK: Number RM 78 Elevation 4808.67

PROPERTY BENCHMARK 4797.39

DESCRIPTION OF PROPERTY BENCHMARK TOP OF 1/2" REBAR AT NORTHWEST CORNER OF PROPOSED 2.01 ACRE PARCEL

GROUND ELEVATIONS AT BUILDING SITE 4797.39 - 4792.22 - 4793.21
(Please provide a minimum of three (3) elevation points, representative of the site)

Sketch of Lot
(include location of property benchmark and building site elevations)

Remarks _____

SEE ATTACHED

BUILDING AREA 1



(Seal)

Signed _____

Company Name _____

1010 S. RD. 1 WEST

Address _____

CHINO VALLEY, AZ 86323

Telephone 636-2046

FOR YAVAPAI COUNTY FLOOD CONTROL DISTRICT USE:

Date: _____

Base Flood Elevation

+ 1.0' = Regulatory Elevation

* ELEVATION DETERMINATIONS ARE BASED ON BEST AVAILABLE DATA WHEN CALCULATED. ELEVATIONS ARE SUBJECT TO CHANGE WHEN NEW OR REVISED FLOOD STUDIES OR DATA IS SUPPLIED TO THE DISTRICT.