ELEVATION CERTIFIC. TE

FEDERAL EMERGENCY MANAGEMENT AGENCY NATIONAL FLOOD INSURANCE PROGRAM

ATTENTION: Use of this certificate does not provide a waiver of the flood insurance purchase requirement. This form is used only to provide elevation information necessary to ensure compliance with applicable community floodplain management ordinances, to determine the proper insurance premium rate, and/or to support a request for a Letter of Map Amendment or Revision (LOMA or LOMR).

Instructions for completing this form can be found on the following pages.

SECTION A PROPERTY INFORMATION	FOR INSURANCE COMPANY USE
BUILDING OWNER'S NAME	POLICY NUMBER
STREET ADDRESS (Including Apt., Unit, Suite and/or Bldg. Number) OR P.O. ROUTE AND BOX NUMBER 0.130 x 850 1987 E Franquero Lin	COMPANY NAIC NUMBER
OTHER DESCRIPTION (Lot and Block Numbers, etc.)	0.10.00.0
CITY of tonwood AS	ZIP CODE 86326
SECTION B FLOOD INSURANCE RATE MAP (FIRM) INFORMATION	1
Provide the following from the proper FIRM (See Instructions):	
1. COMMUNITY NUMBER 2. PANEL NUMBER 3. SUFFIX 4. DATE OF FIRM INDEX 5. FIRM ZONE	6. BASE FLOOD ELEVATION (in AO Zones, use depth)
040093 855 B Aug. 19,1985 A9	3283.8
7. Indicate the elevation datum system used on the FIRM for Base Flood Elevations (BFE): NGVD '29 Other (describe on back) 8. For Zones A or V, where no BFE is provided on the FIRM, and the community has established a BFE for this building site, indicate the community's BFE: feet NGVD (or other FIRM datum—see Section B, Item 7).	
SECTION C BUILDING ELEVATION INFORMATION	
 Using the Elevation Certificate Instructions, indicate the diagram number from the diagrams found on describes the subject building's reference level	r of the reference level from Section B, Item 7). feet above or above or below (check g's lowest floor (reference No Unknown aVD '29 Other (describe ferent than that used on M and show the conversion all floor in place, in which action Elevation Certificate
Section B, Item 7).	o to other i i in datam oco
SECTION D COMMUNITY INFORMATION	,
 If the community official responsible for verifying building elevations specifies that the reference level is not the "lowest floor" as defined in the community's floodplain management ordinance, the elevation floor" as defined by the ordinance is: feet NGVD (or other FIRM datum—see Section 2. Date of the start of construction or substantial improvement 9-20-91. 	n of the building's "lowest


SECTION E CERTIFICATION

This certification is to be signed by a land surveyor, engineer, or architect who is authorized by state or local law to certify elevation information when the elevation information for Zones A1–A30, AE, AH, A (with BFE),V1–V30,VE, and V (with BFE) is required. Community officials who are authorized by local law or ordinance to provide floodplain management information, may also sign the certification. In the case of Zones AO and A (without a FEMA or community issued BFE), a building official, a property owner, or an owner's representative may also sign the certification.

Reference level diagrams 6, 7 and 8 - Distinguishing Features—If the certifier is unable to certify to breakaway/non-breakaway wall, enclosure size, location of servicing equipment, area use, wall openings, or unfinished area Feature(s), then list the Feature(s) not included in the certification under Comments below. The diagram number, Section C, Item 1, must still be entered.

I certify that the information in Sections B and C on this certificate represents my best efforts to interpret the data available. I understand that any false statement may be punishable by fine or imprisonment under 18 U.S. Code, Section 1001.

CERTIFIER'S NAME	RTIFIER'S NAME LICENSE NUMBER (or Affix Seal)	
Elmer 1 (1	aucamb	

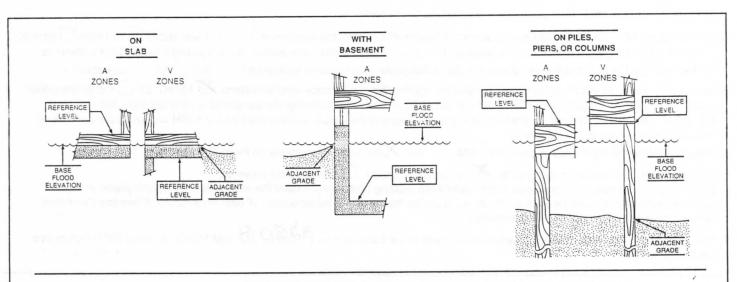

The diagrams above illustrate the points at which the elevations should be measured in A Zones and V Zones.

Elevations for all A Zones should be measured at the top of the reference level floor.

Elevations for all V Zones should be measured at the bottom of the lowest horizontal structural member.