ELEVATION OF FLOODPLAIN PROPERTY

DATE APRIL 19, 1986

ASSESSORS NUMBER 406-47-205

SUBDIVISION NAME & LOT NUMBER LOT 2048 VERDE VILLAGE UNIT 5

OWNER ROBERT WIESE

BASE BENCHMARK NUMBER USED BM. FROM PREVIOUS SURVEY (JOHN BENSON)
(on floodplain circuit)

ELEVATION OF BASE BENCHMARK —

==========

PROPERTY BENCHMARK 3249.95

GROUND ELEVATION AT BUILDING SITE SAME

100 yr. 3251.0 + 1.0 = 3252.0

2.05

==========

DESCRIPTION OF PROPERTY BENCH SET 1/2" REBAR FLUSH w/ GROUND @ APPROX LOT CENTER

==========

Sketch of Lot

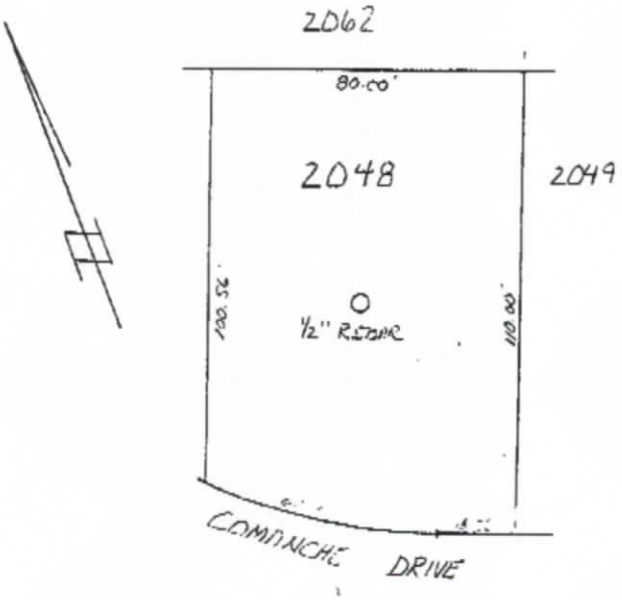

Remarks

Sign:

REGISTERED LAND SURVEYOR
CERTIFICATE NO. 13918
PATRICK W. NAVILLE
4/21/86
ARIZONA, U.S.A.