

FEDERAL EMERGENCY MANAGEMENT AGENCY
NATIONAL FLOOD INSURANCE PROGRAM
POST CONSTRUCTION ELEVATION CERTIFICATE/FLOODPROOFING CERTIFICATE

COMMUNITY NUMBER

INSTRUCTIONS

The registered professional engineer, architect, surveyor or community permit official completes Section I below. Section II may be completed by any of the professionals listed at the beginning of Section II, or by a similarly qualified local permit official. Print or type the information on this form. This form is to be used for new (POST-FIRM) construction and for substantial improvements to existing structures in Zones A1-A30, AH and V1-V30 and existing (PRE-FIRM) buildings to be rated under POST-FIRM rules and rates.

SECTION I
(TO BE COMPLETED BY COMMUNITY PERMIT OFFICIAL)

PROPERTY ADDRESS (or lot and block numbers if address is unavailable)

FIA MAP PANEL ON WHICH PROPERTY IS LOCATED

FIA MAP ZONE IN WHICH PROPERTY IS LOCATED

FIA MAP EFFECTIVE DATE

BASE FLOOD ELEVATION AT THE PROPOSED SITE

START OF CONSTRUCTION DATE

PHONE (with Area Code)

Name and Title

ADDRESS

(Signature)

(Date)

SECTION II

INSTRUCTIONS

Complete only the Elevation Certification unless the building has been floodproofed at least to the base flood elevation. If floodproofing is used, complete only the Floodproofing Certification. The Elevation Certification may be completed by a registered professional engineer, architect, or surveyor. The Floodproofing Certification may only be completed by a registered professional engineer or architect.

ELEVATION CERTIFICATION

VERDE VILLAGE UNIT 5 LOT 2077

I certify that the building at the property location described above has the lowest floor at an elevation of 3246.80 feet, NGVD (mean sea level).

FLOODPROOFING CERTIFICATION

I certify to the best of my knowledge, information, and belief, that the structure is designed so that the structure is watertight to an elevation of _____ feet NGVD (mean sea level), with walls substantially impermeable to the passage of water and structural components having the capability of resisting hydrostatic and hydrodynamic loads and effects of buoyancy that would be caused by the flood depths, pressures, velocities, impact and uplift forces associated with the base flood.

In the event of flooding, will this degree of floodproofing be achieved with human intervention?*

Will the structure be occupied as a residence? _____

If the answer to both questions is Yes, the floodproofing cannot be credited for rating purposes and the elevation certification must be completed instead.

*Floodproofed with human intervention means that water will enter the structure when floods up to the base flood level occur, unless measures are taken prior to the flood to prevent entry of water (e.g. bolting metal shields over doors and windows).

CERTIFIER'S NAME ELEVATION CERTIFICATION ONLY

SCOTT J. SMITH

TITLE



ADDRESS P.O. BOX 130 COTTONWOOD, AZ 86326

Scott J. Smith
(Signature)

10/14/84
(Date)

ARIZONA
RLS 19853

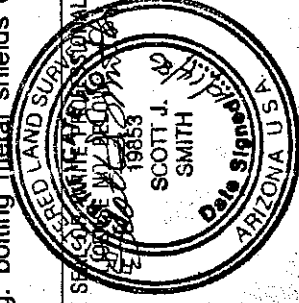

The insurance agent attaches the second copy of the completed form to the flood insurance policy application for new (POST-FIRM) construction or substantial improvements. Be sure that the second copy is certified.

INSURANCE AGENTS MAY ORDER THIS FORM

'As Built' Elevation for Site Built Home

DATE JANUARY 12, 1987

ASSESSORS NUMBER 406-47-234

SUBDIVISION NAME AND NUMBER VERDE VILLAGE UNIT # 5 LOT 2077

OWNER J.D. PAXTON

BASE BENCHMARK NUMBER R.M. 18
(on floodplain circuit)

PROPERTY BENCHMARK ELEVATION 3246.76

=====

SURVEYED FIRST FLOOR ELEVATION 3246.80

REQUIRED FIRST FLOOR ELEVATION
(as per development permit) _____

DIFFERENCE _____


=====

SEE ACCOMPANYING PLAT

REMARKS: Signed

On December 30, 1986, our firm performed a survey and determined the lowest finished flood elevation to be 3246.80 feet.

On January 12, 1987, a survey was performed to determine the second floor elevation at the request of the lot owner, Mr. Paxton. That elevation is 3255.59 feet.

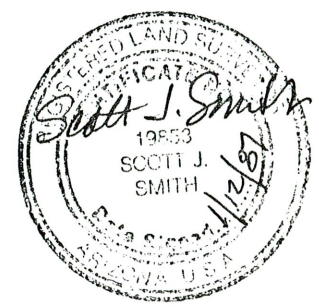

Mingus Associates

CONSULTING ENGINEERS & LAND SURVEYORS

P.O. BOX 1447

COTTONWOOD, ARIZONA 86326

(602) 634-3624 / (602) 634-3625

MICHAEL PEARSON
Designer

ADRIAN R. POLLOCK
Professional Engineer

GEORGE J. LAY
Land Surveyor

TO: Rebba Ludlow, Verde Valley Realty
FROM: Mingus Associates
RE: Flood Plain Elevation Data
DATE: October 30, 1981

Location Lot 2077 - Verde Village No. 5

Elevation of Natural Ground at Southeast front lot
corner, on top rebar 3247.3

Elevation of 100-Year Flood 325.00 3250.0

Floor Elevation Required 3251.00



Respectfully submitted,

Adrian Pollock
Adrian R. Pollock, P.E., L.S.
MINGUS ASSOCIATES

ARP/lb

51.0
47.3
3.7
fringe Area

406-47-234