

OK'd
RE: JIM YOUNG

JOB # 02037

FEDERAL EMERGENCY MANAGEMENT AGENCY
NATIONAL FLOOD INSURANCE PROGRAM

O.M.B. No. 3067-0077
Expires July 31, 2002

ELEVATION CERTIFICATE

Important: Read the instructions on pages 1 - 7.

SECTION A - PROPERTY OWNER INFORMATION

For Insurance Company Use:

BUILDING OWNER'S NAME: RON & SANDRA PETERSON
 BUILDING STREET ADDRESS (Including Apt., Unit, Suite, and/or Bldg. No.) OR P.O. ROUTE AND BOX NO.: 13900 ANGEL VALLEY RD
 CITY: SEDONA STATE: AZ ZIP CODE: 86336
 PROPERTY DESCRIPTION (Lot and Block Numbers, Tax Parcel Number, Legal Description, etc.): 407-25-003 NOW 409-25-002K
 BUILDING USE (e.g., Residential, Non-residential, Addition, Accessory, etc. Use a Comments area, if necessary.): RESIDENTIAL
 LATITUDE/LONGITUDE (OPTIONAL) (##° - ##' - ###" or ##.#####): _____ HORIZONTAL DATUM: SOURCE: GPS (Type): _____
 NAD 1927 NAD 1983 USGS Quad Map Other: _____


SECTION B - FLOOD INSURANCE RATE MAP (FIRM) INFORMATION

B1. NFIP COMMUNITY NAME & COMMUNITY NUMBER: YAVAPAI COUNTY
 B2. COUNTY NAME: YAVAPAI
 B3. STATE: AZ
 B4. MAP AND PANEL NUMBER: 04025C 1465
 B5. SUFFIX: F
 B6. FIRM INDEX DATE: JUNE 6 2001
 B7. FIRM PANEL EFFECTIVE/REVISED DATE: JUNE 6 2001
 B8. FLOOD ZONE(S): AE
 B9. BASE FLOOD ELEVATION(S) (Zone AO, use depth of flooding): 3708.9

B10. Indicate the source of the Base Flood Elevation (BFE) data or base flood depth entered in B9.
 FIS Profile FIRM Community Determined Other (Describe): _____
 B11. Indicate the elevation datum used for the BFE in B9: NGVD 1929 NAVD 1988 Other (Describe): _____
 B12. Is the building located in a Coastal Barrier Resources System (CBRS) area or Otherwise Protected Area (OPA)? Yes No
 Designation Date: _____

SECTION C - BUILDING ELEVATION INFORMATION (SURVEY REQUIRED)

C1. Building elevations are based on: Construction Drawings* Building Under Construction* Finished Construction
 *A new Elevation Certificate will be required when construction of the building is complete.
 C2. Building Diagram Number 1 (Select the building diagram most similar to the building for which this certificate is being completed - see pages 6 and 7. If no diagram accurately represents the building, provide a sketch or photograph.)
 C3. Elevations - Zones A1-A30, AE, AH, A (with BFE), VE, V1-V30, V (with BFE), AR, AR/A, AR/AE, AR/A1-A30, AR/AH, AR/AO
 Complete Items C3.a-i below according to the building diagram specified in Item C2. State the datum used. If the datum is different from the datum used for the BFE in Section B, convert the datum to that used for the BFE. Show field measurements and datum conversion calculation. Use the space provided or the Comments area of Section D or Section G, as appropriate, to document the datum conversion.
 Datum NGVD 29 Conversion/Comments _____
 Elevation reference mark used RM 33A Does the elevation reference mark used appear on the FIRM? Yes No
 a) Top of bottom floor (including basement or enclosure) _____ ft.(m)
 b) Top of next higher floor _____ ft.(m)
 c) Bottom of lowest horizontal structural member (V zones only) _____ ft.(m)
 d) Attached garage (top of slab) 3718.3 ft.(m)
 e) Lowest elevation of machinery and/or equipment servicing the building (Describe in a Comments area.) _____ ft.(m)
 f) Lowest adjacent (finished) grade (LAG) 3718.0 ft.(m)
 g) Highest adjacent (finished) grade (HAG) 3726.5 ft.(m)
 h) No. of permanent openings (flood vents) within 1 ft. above adjacent grade _____
 i) Total area of all permanent openings (flood vents) in C3.h _____ sq. in. (sq. cm)

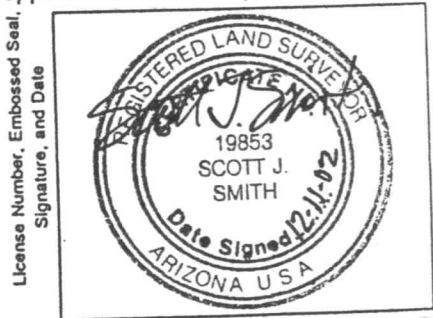

SECTION D - SURVEYOR, ENGINEER, OR ARCHITECT CERTIFICATION

This certification is to be signed and sealed by a land surveyor, engineer, or architect authorized by law to certify elevation information.
 I certify that the information in Sections A, B, and C on this certificate represents my best efforts to interpret the data available.
 I understand that any false statement may be punishable by fine or imprisonment under 18 U.S. Code, Section 1001.

CERTIFIER'S NAME: SCOTT J. SMITH LICENSE NUMBER: AZ RLS #19853
 TITLE: PRESIDENT COMPANY NAME: TRUE NORTH SURVEYS, INC.
 ADDRESS: 4140 WESTERN DR, STE. A CITY: COTTONWOOD STATE: AZ ZIP CODE: 86326
 SIGNATURE: Scott J. Smith DATE: 12-11-02 TELEPHONE: 928-646-5951

IMPORTANT: In these spaces, copy corresponding information from Section A.		For Insurance Company Use:
BUILDING STREET ADDRESS (Including Apt., Unit, Suite, and/or Bldg. No.) OR P.O. ROUTE AND BOX NO.		Policy Number
CITY	STATE	ZIP CODE
		Company NAIC Number

SECTION D - SURVEYOR, ENGINEER, OR ARCHITECT CERTIFICATION (CONTINUED)

Copy both sides of this Elevation Certificate for (1) community official, (2) insurance agent/company, and (3) building owner.

COMMENTS **FINISHED CONSTRUCTION, SLAB ON GRADE**
SEE ATTACHED SKETCH FOR BUILDING LOCATION WITHIN PROPERTY

Check here if attachments

SECTION E - BUILDING ELEVATION INFORMATION (SURVEY NOT REQUIRED) FOR ZONE AO AND ZONE A (WITHOUT BFE)

For Zone AO and Zone A (without BFE), complete Items E1. through E4. If the Elevation Certificate is intended for use as supporting information for a LOMA or LOMR-F, Section C must be completed.

- E1. Building Diagram Number ____ (Select the building diagram most similar to the building for which this certificate is being completed - see pages 6 and 7. If no diagram accurately represents the building, provide a sketch or photograph.)
- E2. The top of the bottom floor (including basement or enclosure) of the building is ____ ft.(m) ____ in.(cm) ____ above or ____ below (check one) the highest adjacent grade. (Use natural grade, if available.)
- E3. For Building Diagrams 6-8 with openings (see page 7), the next higher floor or elevated floor (elevation b) of the building is ____ ft.(m) ____ in.(cm) above the highest adjacent grade. Complete Items C3.h and C3.i on front of form.
- E4. For Zone AO only: If no flood depth number is available, is the top of the bottom floor elevated in accordance with the community's floodplain management ordinance? Yes No Unknown. The local official must certify this information in Section G.

SECTION F - PROPERTY OWNER (OR OWNER'S REPRESENTATIVE) CERTIFICATION

The property owner or owner's authorized representative who completes Sections A, B, C (Items C3.h and C3.i only), and E for Zone A (without a FEMA-issued or community-issued BFE) or Zone AO must sign here. *The statements in Sections A, B, C, and E are correct to the best of my knowledge.*

PROPERTY OWNER'S OR OWNER'S AUTHORIZED REPRESENTATIVE'S NAME _____

ADDRESS _____ CITY _____ STATE _____ ZIP CODE _____

SIGNATURE _____ DATE _____ TELEPHONE _____

COMMENTS _____

Check here if attachments

SECTION G - COMMUNITY INFORMATION (OPTIONAL)

The local official who is authorized by law or ordinance to administer the community's floodplain management ordinance can complete Sections A, B, C (or E), and G of this Elevation Certificate. Complete the applicable item(s) and sign below.

- G1. The information in Section C was taken from other documentation that has been signed and embossed by a licensed surveyor, engineer, or architect who is authorized by state or local law to certify elevation information. (Indicate the source and date of the elevation data in the Comments area below.)
- G2. A community official completed Section E for a building located in Zone A (without a FEMA-issued or community-issued BFE) or Zone AO.
- G3. The following information (Items G4-G9) is provided for community floodplain management purposes.

G4. PERMIT NUMBER No DP	G5. DATE PERMIT ISSUED	G6. DATE CERTIFICATE OF COMPLIANCE/OCCUPANCY ISSUED
-----------------------------------	------------------------	---

- G7. This permit has been issued for: New Construction Substantial Improvement
- G8. Elevation of as-built lowest floor (including basement) of the building is: _____ ft.(m) Datum: _____
- G9. BFE or (in Zone AO) depth of flooding at the building site is: _____ ft.(m) Datum: _____

LOCAL OFFICIAL'S NAME _____ TITLE _____

COMMUNITY NAME _____ TELEPHONE _____

SIGNATURE _____ DATE _____

COMMENTS _____

Check here if attachments

OAK CREEK

48°14'E 2591.78'

ACHMENTS



1109.28'

31

N89°38'31"E 889.08'

438.56'

327.10'

111.45'

563°13'30"E

74.93'

12

(C7)

PARCEL '4'
27.6104 AC.

PARCEL '5'
18.9874 AC.

EXISTING PARCEL 2
BK. 3454, PG. 163
1.2795 AC.

SEE DETAIL SHEET 2

EXISTING PARCEL 1 407-25-003
BK. 3454, PG. 163
0.5031 AC.

1045.48'
S89°59'38"W 1327.21'

C-N 1/16 S11

EXISTING BUILDING

NE 1/16 S11

S00°01'29"W 789.78'

T17N R5E
E 1/16 S12