

ELEVATION CERTIFICATE

Important: Read the instructions on pages 1 - 5.

TNJOB # 02026

SECTION A - PROPERTY OWNER INFORMATION

BUILDING OWNER'S NAME CYNTHIA PHILLIPS		For Insurance Company Use: Policy Number
BUILDING STREET ADDRESS (Including Apt., Unit, Suite, and/or Bldg. No.) OR P.O. ROUTE AND BOX NO. 10305 E. Oak Creek Valley Drive		Company NAIC Number
CITY Cornville	STATE AZ	ZIP CODE 86325
PROPERTY DESCRIPTION (Lot and Block Numbers, Tax Parcel Number, Legal Description, etc.) AP# 407-34-149 LOT 148, OAK CREEK VALLEY UNIT #2		
BUILDING USE (e.g., Residential, Non-residential, Addition, Accessory, etc. Use comments section if necessary.)		

LATITUDE/LONGITUDE (OPTIONAL) (##° - ##' - ###" or ##.#####) HORIZONTAL DATUM: NAD 1927 NAD 1983 SOURCE: GPS (Type: _____) USGS Quad Map Other: _____


SECTION B - FLOOD INSURANCE RATE MAP (FIRM) INFORMATION

B1. NFIP COMMUNITY NAME & COMMUNITY NUMBER Yavapai 040093		B2. COUNTY NAME Yavapai		B3. STATE Arizona	
B4. MAP AND PANEL NUMBER 04025C 181D	B5. SUFFIX F	B6. FIRM INDEX DATE June 6, 01	B7. FIRM PANEL EFFECTIVE/REVISED DATE June 6, 01	B8. FLOOD ZONE(S) AE	B9. BASE FLOOD ELEVATION(S) (Zone AO, use depth of flooding) 3362.0

- B10. Indicate the source of the Base Flood Elevation (BFE) data or base flood depth entered in B9.
 FIS Profile FIRM Community Determined Other (Describe: _____)
- B11. Indicate the elevation datum used for the BFE in B9: NGVD 1929 NAVD 1988 Other (Describe: _____)
- B12. Is the building located in a Coastal Barrier Resources System (CBRS) area or Otherwise Protected Area (OPA)? Yes No
 Designation Date: _____

SECTION C - BUILDING ELEVATION INFORMATION (SURVEY REQUIRED)

- C1. Building elevations are based on: Construction Drawings* Building Under Construction* Finished Construction
 *A new Elevation Certificate will be required when construction of the building is complete.
- C2. Building Diagram Number 8 (Select the building diagram most similar to the building for which this certificate is being completed - see pages 4 and 5. If no diagram accurately represents the building, provide a sketch or photograph.)
- C3. Elevations - Zones A1-A30, AE, AH, A (with BFE), VE, V1-V30, V (with BFE), AR, AR/A, AR/AE, AR/A1-A30, AR/AH, AR/AO
 Complete Items C3a-i below according to the building diagram specified in Item C2. State the datum used. If the datum is different from the datum used for the BFE in Section B, convert the datum to that used for the BFE. Show field measurements and datum conversion calculation. Use the space provided or the Comments area of Section D or Section G, as appropriate, to document the datum conversion.
 Datum NGVD 1929 Conversion/Comments _____
 Elevation reference mark used RM # 81 Does the elevation reference mark used appear on the FIRM? Yes No
- | | | | |
|---|-------------|-----------|------------------|
| <input type="checkbox"/> a) Top of bottom floor (including basement or enclosure) DECK | <u>3363</u> | <u>15</u> | ft.(m) |
| <input type="checkbox"/> b) Top of next higher floor RESIDENCE | <u>3363</u> | <u>25</u> | ft.(m) |
| <input type="checkbox"/> c) Bottom of lowest horizontal structural member (V zones only) | <u>N/A</u> | | ft.(m) |
| <input type="checkbox"/> d) Attached garage (top of slab) | <u>3361</u> | <u>2</u> | ft.(m) |
| <input type="checkbox"/> e) Lowest elevation of machinery and/or equipment servicing the building | <u>N/A</u> | | ft.(m) |
| <input type="checkbox"/> f) Lowest adjacent grade (LAG) | <u>3358</u> | <u>0</u> | ft.(m) |
| <input type="checkbox"/> g) Highest adjacent grade (HAG) | <u>3361</u> | <u>0</u> | ft.(m) |
| <input type="checkbox"/> h) No. of permanent openings (flood vents) within 1 ft. above adjacent grade | <u>15</u> | | |
| <input type="checkbox"/> i) Total area of all permanent openings (flood vents) in C3h | <u>1800</u> | | sq. in. (sq. cm) |

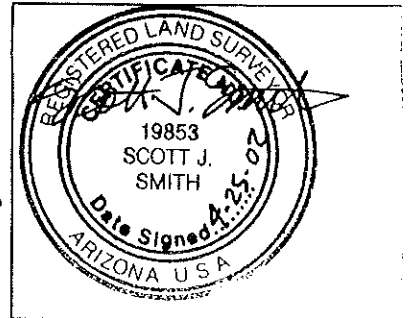

SECTION D - SURVEYOR, ENGINEER, OR ARCHITECT CERTIFICATION

This certification is to be signed and sealed by a land surveyor, engineer, or architect authorized by law to certify elevation information. I certify that the information in Sections A, B, and C on this certificate represents my best efforts to interpret the data available. I understand that any false statement may be punishable by fine or imprisonment under 18 U.S. Code, Section 1001.

CERTIFIER'S NAME **SCOTT J. SMITH** LICENSE NUMBER **AZ RLS # 19853**

TITLE **Registered Land Surveyor, President** COMPANY NAME **True North Surveys, Inc.**

ADDRESS **4140 Western Dr. Suite A** CITY **Cottonwood** STATE **AZ** ZIP CODE **86326**

SIGNATURE *Scott J. Smith* DATE **4-24-02** TELEPHONE **928-646-5951**

IMPORTANT: In these spaces, copy the corresponding information from Section A.

BUILDING STREET ADDRESS (Including Apt. No., Suite, and/or Bldg. No.) OR P.O. ROUTE AND E	IO.	For Insurance Company Use: Policy Number
CITY	STATE	ZIP CODE
		Company NAIC Number

SECTION D - SURVEYOR, ENGINEER, OR ARCHITECT CERTIFICATION (CONTINUED)

Copy both sides of this Elevation Certificate for (1) community official, (2) insurance agent/company, and (3) building owner.

COMMENTS The new construction consists of enclosing an existing attached deck (Elevation = C3a). The deck is open to flow as indicated on Diagram 5. The existing site built home (Elevation = C3b) is represented by Diagram 8 and is not being altered.

SECTION E - BUILDING ELEVATION INFORMATION (SURVEY NOT REQUIRED) FOR ZONES AO and A (WITHOUT BFE)

For Zones AO and A (without BFE), complete Items E1 through E3. If the Elevation Certificate is intended for use as supporting information for a LOMA or LOMR-F, Section C must be completed.

- E1. Building Diagram Number ____ (Select the building diagram most similar to the building for which this certificate is being completed - see pages 4 and 5. If no diagram accurately represents the building, provide a sketch or photograph.)
- E2. The top of the bottom floor (including basement or enclosure) of the building is ft.(m) in.(cm) above or below (check one) the highest adjacent grade.
- E3. For Zone AO only: If no flood depth number is available, is the top of the bottom floor elevated in accordance with the community's floodplain management ordinance? Yes No Unknown. The local official must certify this information in Section G.

SECTION F - PROPERTY OWNER (OR OWNER'S REPRESENTATIVE) CERTIFICATION

The property owner or owner's authorized representative who completes Sections A, B, and E for Zone A (without a FEMA-issued or community-issued BFE) or Zone AO must sign here.

PROPERTY OWNER'S OR OWNER'S AUTHORIZED REPRESENTATIVE'S NAME _____

ADDRESS _____ CITY _____ STATE _____ ZIP CODE _____

SIGNATURE _____ DATE _____ TELEPHONE _____

COMMENTS _____

SECTION G - COMMUNITY INFORMATION (OPTIONAL)

The local official who is authorized by law or ordinance to administer the community's floodplain management ordinance can complete Sections A, B, C (or E), and G of this Elevation Certificate. Check the applicable box(es) and sign below.

- G1. The information in Section C was taken from other documentation that has been signed and embossed by a licensed surveyor, engineer, or architect who is authorized by state or local law to certify elevation information. (Indicate the source and date of the elevation data in the Comments area below.)
- G2. A community official completed Section E for a building located in Zone A (without a FEMA-issued or community-issued BFE) or Zone AO.
- G3. The following information (Items G4-G9) is provided for community floodplain management purposes.

G4. PERMIT NUMBER	G5. DATE PERMIT ISSUED	G6. DATE CERTIFICATE OF COMPLIANCE/OCCUPANCY ISSUED
-------------------	------------------------	---

- G7. This permit has been issued for: New Construction Substantial Improvement
- G8. Elevation of as-built lowest floor (including basement) of the building is: _____ ft.(m) Datum: _____
- G9. BFE or (in Zone AO) depth of flooding at the building site is: _____ ft.(m) Datum: _____

LOCAL OFFICIAL'S NAME _____ TITLE _____

COMMUNITY NAME _____ TELEPHONE _____

SIGNATURE _____ DATE _____

COMMENTS _____

Check here if attachments

"AS BUILT" ELEVATIONS FOR EITHER MANUFACTURED HOMES OR SITE BUILT HOMES
When Completed Return To: Yavapai County Flood Control District

Section 1 - Complete entire section

DATE JANUARY 2, 1995 ASSESSORS NUMBER 407-34-149

SUBDIVISION NAME AND LOT NUMBER LOT 148 - OAK CREEK VALLEY II

OWNER LOMA LINDA UNIVERSITY

BASE BENCHMARK NUMBER (on floodplain circuit) RM 29

PROPERTY BENCHMARK ELEVATION N/A

DIAGRAM # (from Page 5 & 6 of OMB No. 3067-0070) 7

Section 2 - Complete if appropriate

'As Built' Elevation for Manufactured Homes

SURVEYED BOTTOM OF STRUCTURAL FRAME _____

(seal)

Signed _____


Section 3 - Complete if appropriate

'As Built' Elevation for site Built Homes

SURVEYED LOWEST FLOOR _____

3363 24

(seal)

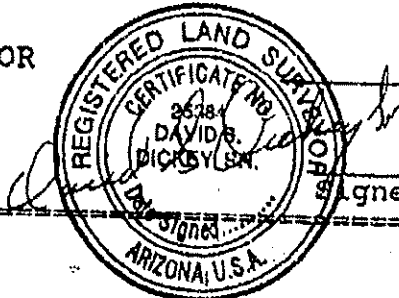

Signed _____

FOR DISTRICT USE:

REQUIRED ELEVATION TO BOTTOM OF STRUCTURAL FRAME _____

(As Per Development Permit _____)

DIFFERENCE _____

REQUIRED LOWEST FLOOR ELEVATION _____

(As Per Development Permit _____)

DIFFERENCE _____

Submitted to FCD. April 24, 01