

QUOTE #14807931

U S DEPARTMENT OF HOMELAND SECURITY  
Federal Emergency Management Agency  
National Flood Insurance Program

**ELEVATION CERTIFICATE**

OMB No. 1660-0008  
Expires March 31, 2012


Important: Read the instructions on pages 1-9.

SECTION A - PROPERTY INFORMATION		For Insurance Company Use:
A1 Building Owner's Name <b>FIREFOX PROPERTIES, LLC</b>		Policy Number
A2 Building Street Address (including Apt., Unit, Suite, and/or Bldg. No.) or P.O. Route and Box No. <b>1075 S STATE ROUTE 260</b>		Company NAIC Number
City <b>COTTONWOOD</b> State <b>AZ</b> ZIP Code <b>86326</b>		
A3 Property Description (Lot and Block Numbers, Tax Parcel Number, Legal Description, etc.) <b>APN 406-04-057G METES AND BOUNDS DESCRIBED IN BOOK 4492, PAGE 702, YAVAPAI COUNTY RECORDER.</b>		
A4 Building Use (e.g., Residential, Non-Residential, Addition, Accessory, etc.) <b>NON-RESIDENTIAL</b>		
A5 Latitude/Longitude: Lat. <b>34°43'11.9"N</b> Long. <b>112°005.9"W</b>		Horizontal Datum: <input type="checkbox"/> NAD 1927 <input checked="" type="checkbox"/> NAD 1983
A6 Attach at least 2 photographs of the building if the Certificate is being used to obtain flood insurance.		
A7 Building Diagram Number <b>1B</b>		
A8 For a building with a crawlspace or enclosure(s):		A9 For a building with an attached garage:
a) Square footage of crawlspace or enclosure(s) <b>400</b> sq ft		a) Square footage of attached garage <b>N/A</b> sq ft
b) No. of permanent flood openings in the crawlspace or enclosure(s) within 10 foot above adjacent grade <b>11</b>		b) No. of permanent flood openings in the attached garage within 10 foot above adjacent grade <b>N/A</b>
c) Total net area of flood openings in A8.b <b>380</b> sq in		c) Total net area of flood openings in A9.b <b>N/A</b> sq in
d) Engineered flood openings? <input type="checkbox"/> Yes <input type="checkbox"/> No		d) Engineered flood openings? <input type="checkbox"/> Yes <input type="checkbox"/> No

SECTION B - FLOOD INSURANCE RATE MAP (FIRM) INFORMATION					
B1 NFIP Community Name & Community Number <b>COTTONWOOD, CITY OF 040086</b>		B2 County Name <b>YAVAPAI</b>		B3 State <b>ARIZONA</b>	
B4 Map/Panel Number <b>04025C1757</b>	B5 Suffix <b>G</b>	B6 FIRM Index Date <b>9/3/2010</b>	B7 FIRM Panel Effective/Revised Date <b>9/3/2010</b>	B8 Flood Zone(s) <b>A, X</b>	B9 Base Flood Elevation(s) (Zone AO, use base flood depth) <b>3317.0</b>
B10 Indicate the source of the Base Flood Elevation (BFE) data or base flood depth entered in Item B9. <input checked="" type="checkbox"/> FIS Profile <input type="checkbox"/> FIRM <input type="checkbox"/> Community Determined <input type="checkbox"/> Other (Describe) _____					
B11 Indicate elevation datum used for BFE in Item B9: <input type="checkbox"/> NGVD 1929 <input checked="" type="checkbox"/> NAVD 1988 <input type="checkbox"/> Other (Describe) _____					
B12 Is the building located in a Coastal Barrier Resources System (CBRS) area or Otherwise Protected Area (OPA)? <input type="checkbox"/> Yes <input checked="" type="checkbox"/> No Designation Date _____ <input type="checkbox"/> CBRS <input type="checkbox"/> OPA					

SECTION C - BUILDING ELEVATION INFORMATION (SURVEY REQUIRED)	
C1. Building elevations are based on: <input type="checkbox"/> Construction Drawings* <input type="checkbox"/> Building Under Construction* <input checked="" type="checkbox"/> Finished Construction	
*A new Elevation Certificate will be required when construction of the building is complete.	
C2. Elevations - Zones A1-A30, AE, AH, A (with BFE), VE, V1-V30, V (with BFE), AR, AR/A, AR/AE, AR/A1-A30, AR/AH, AR/AO. Complete Items C2 a-h below according to the building diagram specified in Item A7. Use the same datum as the BFE.	
Benchmark Utilized <b>RM271</b> Vertical Datum <b>NAD88</b>	
Conversion/Comments <b>CONVERSION FROM NGVD29 2.51 FEET PUBLISHED IN FIS</b>	
Check the measurement used	
a) Top of bottom floor (including basement, crawlspace, or enclosure floor) <b>3319.7</b>	<input checked="" type="checkbox"/> feet <input type="checkbox"/> meters (Puerto Rico only)
b) Top of the next higher floor <b>3320.7</b>	<input checked="" type="checkbox"/> feet <input type="checkbox"/> meters (Puerto Rico only)
c) Bottom of the lowest horizontal structural member (V Zones only) <b>N/A</b>	<input type="checkbox"/> feet <input type="checkbox"/> meters (Puerto Rico only)
d) Attached garage (top of slab) <b>N/A</b>	<input type="checkbox"/> feet <input type="checkbox"/> meters (Puerto Rico only)
e) Lowest elevation of machinery or equipment servicing the building (Describe type of equipment and location in Comments) <b>3321.1</b>	<input checked="" type="checkbox"/> feet <input type="checkbox"/> meters (Puerto Rico only)
f) Lowest adjacent (finished) grade next to building (LAG) <b>3318.2</b>	<input checked="" type="checkbox"/> feet <input type="checkbox"/> meters (Puerto Rico only)
g) Highest adjacent (finished) grade next to building (HAG) <b>3320.7</b>	<input checked="" type="checkbox"/> feet <input type="checkbox"/> meters (Puerto Rico only)
h) Lowest adjacent grade at lowest elevation of deck or stairs, including structural support <b>3318.2</b>	<input checked="" type="checkbox"/> feet <input type="checkbox"/> meters (Puerto Rico only)

SECTION D - SURVEYOR, ENGINEER, OR ARCHITECT CERTIFICATION	
This certification is to be signed and sealed by a land surveyor, engineer, or architect authorized by law to certify elevation information. I certify that the information on this Certificate represents my best efforts to interpret the data available. I understand that any false statement may be punishable by fine or imprisonment under 18 U.S. Code, Section 1001. <input type="checkbox"/>	
Check here if comments are provided on back of form <input type="checkbox"/> Were latitude and longitude in Section A provided by a licensed land surveyor? <input checked="" type="checkbox"/> Yes <input type="checkbox"/> No	
Certifier's Name <b>IVO W. BUDDEKE</b>	License Number <b>32230</b>
Title <b>OWNER</b>	Company Name <b>RIMROCK LAND SURVEYS</b>
Address <b>5280 BENTLEY DRIVE</b>	City <b>RIMROCK</b> State <b>AZ</b> ZIP Code <b>86335</b>
Signature <i>IVO W. BUDDEKE</i>	Date <b>10/21/2010</b> Telephone <b>928-567-1414</b>

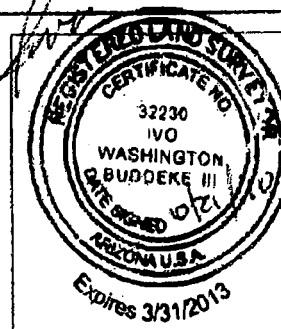

VUOTE #14807937

<b>IMPORTANT: In these spaces, copy the corresponding information from Section A.</b>	<b>For Insurance Company Use:</b>
Building Street Address (including Apt., Unit, Suite, and/or Bldg. No.) or P.O. Route and Box No. 1075 S STATE ROUTE 260	Policy Number
City COTTONWOOD State AZ ZIP Code 86326	Company NAIC Number

**SECTION D - SURVEYOR, ENGINEER, OR ARCHITECT CERTIFICATION (CONTINUED)**

Copy both sides of this Elevation Certificate for (1) community official, (2) insurance agent/company, and (3) building owner.

Comments \* BUILDING TYPE (1B) FOR THE MAJORITY OF THE BUILDING, A SMALL ADDITION ON THE NORTHEAST END THAT IS BUILDING TYPE IS (8). STRUCTURES ARE WOOD FRAME/ STUCCO EXTERIOR MAIN BUILDING SLAB ON FILL, ADDITION BUILT ON STEM WALL WITH CRAWL SPACE & FLOOD OPENINGS. (SEE SECTION A8) MECHANICAL SMALL HOT WATER HEATER 0.4 FEET ABOVE FINISHED FLOOR OF HIGHER FLOOR AT ELEV (3320.7' + 0.4') THE REMAINING MECHANICAL COMPONENTS ARE ROOF MOUNTED SPLIT LEVEL MAIN BUILDING ON THE NORTH SIDE IS 1 FOOT HIGHER THAN THE SOUTH SIDE AND THE ADDITION ON THE NORTHEAST CRAWL SPACE ELEV 3318.5

Signature

Date

10/21/10

☐ Check here if attachments**SECTION E - BUILDING ELEVATION INFORMATION (SURVEY NOT REQUIRED) FOR ZONE AO AND ZONE A (WITHOUT BFE)**

For Zones AO and A (without BFE), complete items E1-E5. If the Certificate is intended to support a LOMA or LOMR-F request, complete Sections A, B, and C. For items E1-E4, use natural grade, if available. Check the measurement used. In Puerto Rico only, enter meters.

- E1 Provide elevation information for the following and check the appropriate boxes to show whether the elevation is above or below the highest adjacent grade (HAG) and the lowest adjacent grade (LAG):
- a) Top of bottom floor (including basement, crawlspace, or enclosure) is \_\_\_\_\_ ☐ feet ☐ meters ☐ above or ☐ below the HAG
- b) Top of bottom floor (including basement, crawlspace, or enclosure) is \_\_\_\_\_ ☐ feet ☐ meters ☐ above or ☐ below the LAG
- E2 For Building Diagrams 6-9 with permanent flood openings provided in Section A Items 8 and/or 9 (see pages 8-9 of Instructions), the next higher floor (elevation C2.b in the diagrams) of the building is \_\_\_\_\_ ☐ feet ☐ meters ☐ above or ☐ below the HAG
- E3 Attached garage (top of slab) is \_\_\_\_\_ ☐ feet ☐ meters ☐ above or ☐ below the HAG.
- E4 Top of platform of machinery and/or equipment servicing the building is \_\_\_\_\_ ☐ feet ☐ meters ☐ above or ☐ below the HAG
- E5 Zone AO only: If no flood depth number is available, is the top of the bottom floor elevated in accordance with the community's floodplain management ordinance? ☐ Yes ☐ No ☐ Unknown. The local official must certify this information in Section G.

**SECTION F - PROPERTY OWNER (OR OWNER'S REPRESENTATIVE) CERTIFICATION**

The property owner or owner's authorized representative who completes Sections A, B, and E for Zone A (without a FEMA-issued or community-issued BFE) or Zone AO must sign here. The statements in Sections A, B, and E are correct to the best of my knowledge.

Property Owner's or Owner's Authorized Representative's Name

Address	City	State	ZIP Code
Signature	Date	Telephone	
Comments			

☐ Check here if attachments**SECTION G - COMMUNITY INFORMATION (OPTIONAL)**

The local official who is authorized by law or ordinance to administer the community's floodplain management ordinance can complete Sections A, B, C (or E), and G of this Elevation Certificate. Complete the applicable item(s) and sign below. Check the measurement used in items G8 and G9.

- G1. ☐ The information in Section C was taken from other documentation that has been signed and sealed by a licensed surveyor, engineer, or architect who is authorized by law to certify elevation information. (Indicate the source and date of the elevation data in the Comments area below.)
- G2. ☐ A community official completed Section E for a building located in Zone A (without a FEMA-issued or community-issued BFE) or Zone AO.
- G3. ☐ The following information (Items G4-G9) is provided for community floodplain management purposes.

G4 Permit Number	G5 Date Permit Issued	G6 Date Certificate Of Compliance/Occupancy Issued
------------------	-----------------------	--

- G7. This permit has been issued for: ☐ New Construction ☐ Substantial Improvement
- G8. Elevation of as-built lowest floor (including basement) of the building: \_\_\_\_\_ ☐ feet ☐ meters (PR) Datum \_\_\_\_\_
- G9. BFE or (in Zone AO) depth of flooding at the building site: \_\_\_\_\_ ☐ feet ☐ meters (PR) Datum \_\_\_\_\_
- G10. Community's design flood elevation: \_\_\_\_\_ ☐ feet ☐ meters (PR) Datum \_\_\_\_\_

Local Official's Name	Title
Community Name	Telephone
Signature	Date
Comments	

☐ Check here if attachments

QUOTE #14807937

DEPARTMENT OF HOMELAND SECURITY FEDERAL EMERGENCY MANAGEMENT AGENCY STANDARD FLOOD HAZARD DETERMINATION FORM (SFHDF)		See The Attached Instructions	O.M.B No. 1660-0040 Expires December 31, 2011	
<b>SECTION I - LOAN INFORMATION</b>				
<b>1. LENDER NAME AND ADDRESS</b> Auto-Owners 6600 Rockledge Drive Bethesda, MD 20817  <u>PolicyId:</u> 14807937 <u>Branch:</u> 025008100 <u>Attn:</u> CINDY COVIN		<b>2. COLLATERAL (Building/Mobile Home/Personal Property) PROPERTY ADDRESS</b> (Legal Description may be attached) 1075 S SR 260 COTTONWOOD, AZ 86326  <u>Insured:</u> FIREFOX, PROPERTIES, LLC		
<b>3. LENDER ID. NO.</b>	<b>4. LOAN IDENTIFIER</b> 14807937	<b>5. AMOUNT OF FLOOD INSURANCE REQUIRED</b> \$		
<b>SECTION II</b>				
<b>A. NATIONAL FLOOD INSURANCE PROGRAM (NFIP) COMMUNITY JURISDICTION</b>				
<b>1. NFIP Community Name</b> COTTONWOOD, TOWN OF		<b>2. County(ies)</b> YAVAPAI	<b>3. State</b> AZ	<b>4. NFIP Community Number</b> 040096
<b>B. NATIONAL FLOOD INSURANCE PROGRAM (NFIP) DATA AFFECTING BUILDING/MOBILE HOME</b>				
<b>1. NFIP Map Number or Community Panel Number</b> (Community name, if not the same as "A") 04025C 1757G		<b>2. NFIP Map Panel Effective/ Revised Date</b> 09/03/10	<b>3. LOMA/LOMR</b> <input type="checkbox"/> Yes <input type="checkbox"/> No Date	<b>4. Flood Zone</b> AE  <b>5. No NFIP Map</b>
<b>C. FEDERAL FLOOD INSURANCE AVAILABILITY (Check all that apply)</b>				
1. <input checked="" type="checkbox"/> Federal Flood Insurance is available (community participates in NFIP). <input checked="" type="checkbox"/> Regular Program <input type="checkbox"/> Emergency Program of NFIP				
2. <input type="checkbox"/> Federal Flood Insurance is not available because community is not participating in the NFIP.				
3. <input type="checkbox"/> Building/Mobile Home is in a Coastal Barrier Resources Area (CBRA) or Otherwise Protected Area (OPA), Federal Flood Insurance may not be available CBRA/OPA designation date: _____				
<b>D. DETERMINATION</b>				
<b>IS BUILDING/MOBILE HOME IN SPECIAL FLOOD HAZARD AREA (ZONE CONTAINING THE LETTERS "A" OR "V") ?</b> <input checked="" type="checkbox"/> YES <input type="checkbox"/> NO If yes, flood insurance is required by the Flood Disaster Protection Act of 1973. If no, flood insurance is not required by the Flood Disaster Protection Act of 1973.				
<b>E. COMMENTS (Optional):</b> 1. Community firm date: 09/16/1981 2. BFE: 3314 (NAVD88)				
This determination is based on examining the NFIP map, any Federal Emergency Management Agency revisions to it, and any other information needed to locate the building/mobile home on the NFIP map.				
<b>F. PREPARER'S INFORMATION</b>				
<b>NAME, ADDRESS, TELEPHONE NUMBER (If other than Lender)</b> CoreLogic Flood Services 11902 Burnet Road Austin, TX 78758 1-800-447-1772			<b>DATE OF DETERMINATION</b> 10/08/10 at 02:16 PM CDT  <b>FloodCert #:</b> 1010C39079	