

# ELEVATION CERTIFICATE

OMB No. 1660-0008  
Expires February 28, 2009

Important: Read the instructions on pages 1-8.

## SECTION A - PROPERTY INFORMATION

|   |                    |   |  |
|---|--------------------|---|--|
| A1. Building Owner's Name<br><u>PIZZA HUT OF ARIZONA</u>   |                    | For Insurance Company Use:<br>Policy Number                                                                |  |
| A2. Building Street Address (including Apt., Unit, Suite, and/or Bldg. No.) or P.O. Route and Box No.<br><u>472 SOUTH MAIN STREET</u>                                              |                    | Company NAIC Number                                                                                        |  |
| City<br><u>COTTONWOOD</u>   | State<br><u>AZ</u> | ZIP Code<br><u>86326</u>                                                                                   |  |
| A3. Property Description (Lot and Block Numbers, Tax Parcel Number, Legal Description, etc.)<br><u>LOT 14 CHERRY PARK SUBD Per BK 21 OF MAPS PG 28</u>                             |                    |   |  |
| A4. Building Use (e.g., Residential, Non-Residential, Addition, Accessory, etc.)<br><u>COMMERCIAL</u>                                                                              |                    |   |  |
| A5. Latitude/Longitude: Lat. <u>N 34° 43' 49.6"</u> Long. <u>W 112° 00' 37.9"</u> Horizontal Datum: <input type="checkbox"/> NAD 1927 <input checked="" type="checkbox"/> NAD 1983 |                    |   |  |
| A6. Attach at least 2 photographs of the building if the Certificate is being used to obtain flood insurance.                                                                      |                    |   |  |
| A7. Building Diagram Number <u>1</u>   |                    |   |  |
| A8. For a building with a crawl space or enclosure(s), provide: <u>N/A</u>   |                    | A9. For a building with an attached garage, provide: <u>N/A</u>                                            |  |
| a) Square footage of crawl space or enclosure(s) _____ sq ft   |                    | a) Square footage of attached garage _____ sq ft                                                           |  |
| b) No. of permanent flood openings in the crawl space or enclosure(s) walls within 1.0 foot above adjacent grade _____                                                             |                    | b) No. of permanent flood openings in the attached garage walls within 1.0 foot above adjacent grade _____ |  |
| c) Total net area of flood openings in A8.b. _____ sq in   |                    | c) Total net area of flood openings in A9.b. _____ sq in                                                   |  |

## SECTION B - FLOOD INSURANCE RATE MAP (FIRM) INFORMATION

|   |                        |                                   |                                                              |                               |                                                                            |
|---|------------------------|-----------------------------------|--------------------------------------------------------------|-------------------------------|----------------------------------------------------------------------------|
| B1. NFIP Community Name & Community Number<br><u>CITY OF COTTONWOOD 040006</u>   |                        | B2. County Name<br><u>YAVAPAI</u> |                                                              | B3. State<br><u>AZ</u>        |                                                                            |
| B4. Map/Panel Number<br><u>1782</u>   | B5. Suffix<br><u>F</u> | B6. FIRM Index Date               | B7. FIRM Panel Effective/Revised Date<br><u>JUNE 6, 2001</u> | B8. Flood Zone(s)<br><u>X</u> | B9. Base Flood Elevation(s) (Zone AO, use base flood depth)<br><u>3350</u> |
| B10. Indicate the source of the Base Flood Elevation (BFE) data or base flood depth entered in Item B9.<br><input type="checkbox"/> FIS Profile <input checked="" type="checkbox"/> FIRM <input type="checkbox"/> Community Determined <input type="checkbox"/> Other (Describe) _____ |                        |                                   |                                                              |                               |                                                                            |
| B11. Indicate elevation datum used for BFE in Item B9: <input checked="" type="checkbox"/> NGVD 1929 <input type="checkbox"/> NAVD 1988 <input type="checkbox"/> Other (Describe) _____                                                                                                |                        |                                   |                                                              |                               |                                                                            |
| B12. Is the building located in a Coastal Barrier Resources System (CBRS) area or Otherwise Protected Area (OPA)?<br>Designation Date _____ <input type="checkbox"/> CBRS <input type="checkbox"/> OPA <input type="checkbox"/> Yes <input checked="" type="checkbox"/> No             |                        |                                   |                                                              |                               |                                                                            |

## SECTION C - BUILDING ELEVATION INFORMATION (SURVEY REQUIRED)

C1. Building elevations are based on: ☐ Construction Drawings\* ☐ Building Under Construction\* ☒ Finished Construction  
\*A new Elevation Certificate will be required when construction of the building is complete.

C2. Elevations - Zones A1-A30, AE, AH, A (with BFE), VE, V1-V30, V (with BFE), AR, AR/A, AR/AE, AR/A1-A30, AR/AH, AR/AO. Complete Items C2.a-g below according to the building diagram specified in Item A7.

Benchmark Utilized RM 249 Per FIRM Vertical Datum NGVD27  
Conversion/Comments N65 Brass Cap in CBS Headmark = 3345.49

Check the measurement used.


|   |                |                                          |                                                    |
|---|----------------|------------------------------------------|----------------------------------------------------|
| a) Top of bottom floor (including basement, crawl space, or enclosure floor)                                     | <u>3351.65</u> | <input checked="" type="checkbox"/> feet | <input type="checkbox"/> meters (Puerto Rico only) |
| b) Top of the next higher floor                                                                                  | <u>-</u>       | <input type="checkbox"/> feet            | <input type="checkbox"/> meters (Puerto Rico only) |
| c) Bottom of the lowest horizontal structural member (V Zones only)                                              | <u>-</u>       | <input type="checkbox"/> feet            | <input type="checkbox"/> meters (Puerto Rico only) |
| d) Attached garage (top of slab)                                                                                 | <u>-</u>       | <input type="checkbox"/> feet            | <input type="checkbox"/> meters (Puerto Rico only) |
| e) Lowest elevation of machinery or equipment servicing the building<br>(Describe type of equipment in Comments) | <u>3351.65</u> | <input checked="" type="checkbox"/> feet | <input type="checkbox"/> meters (Puerto Rico only) |
| f) Lowest adjacent (finished) grade (LAG)                                                                        | <u>3350.95</u> | <input checked="" type="checkbox"/> feet | <input type="checkbox"/> meters (Puerto Rico only) |
| g) Highest adjacent (finished) grade (HAG)                                                                       | <u>3351.23</u> | <input checked="" type="checkbox"/> feet | <input type="checkbox"/> meters (Puerto Rico only) |

## SECTION D - SURVEYOR, ENGINEER, OR ARCHITECT CERTIFICATION

This certification is to be signed and sealed by a land surveyor, engineer, or architect authorized by law to certify elevation information. I certify that the information on this Certificate represents my best efforts to interpret the data available. I understand that any false statement may be punishable by fine or imprisonment under 18 U.S. Code, Section 1001.

☒ Check here if comments are provided on back of form.

Certifier's Name Britt DeMuth License Number AZ ELS 15853  
Title PR. AZTECH DESIGN INC Company Name PR. AZTECH DESIGN INC  
Address PO BOX 424 Flagstaff AZ 86002 City Flagstaff State AZ ZIP Code 86002  
Signature Britt DeMuth Date 12-10-07 Telephone 928 774 4409

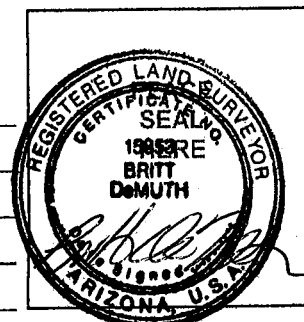

**IMPORTANT: In these spaces, copy the corresponding information from Section A.**

Building Street Address (including Apt., Unit, Suite, and/or Bldg. No.) or P.O. Route and Box No.

472 SOUTH MAIN STREET

City

COTTONWOOD

State

ARIZONA

ZIP Code

86306

For Insurance Company Use:

Policy Number

Company NAIC Number

**SECTION D - SURVEYOR, ENGINEER, OR ARCHITECT CERTIFICATION (CONTINUED)**

Copy both sides of this Elevation Certificate for (1) community official, (2) insurance agent/company, and (3) building owner.

Comments

Item C2(c). All equipment is on the building roof or in the building itself. All photos taken on 12-06-07.

Signature

Bobb Upton

Date

12-10-07

☒ Check here if attachments**SECTION E - BUILDING ELEVATION INFORMATION (SURVEY NOT REQUIRED) FOR ZONE AO AND ZONE A (WITHOUT BFE)**

For Zones AO and A (without BFE), complete Items E1-E5. If the Certificate is intended to support a LOMA or LOMR-F request, complete Sections A, B, and C. For Items E1-E4, use natural grade, if available. Check the measurement used. In Puerto Rico only, enter meters.

E1. Provide elevation information for the following and check the appropriate boxes to show whether the elevation is above or below the highest adjacent grade (HAG) and the lowest adjacent grade (LAG).

a) Top of bottom floor (including basement, crawl space, or enclosure) is \_\_\_\_\_ feet \_\_\_\_\_ meters ☐ above or ☐ below the HAG.b) Top of bottom floor (including basement, crawl space, or enclosure) is \_\_\_\_\_ feet \_\_\_\_\_ meters ☐ above or ☐ below the LAG.E2. For Building Diagrams 6-8 with permanent flood openings provided in Section A Items 8 and/or 9 (see page 8 of Instructions), the next higher floor (elevation C2.b in the diagrams) of the building is \_\_\_\_\_ feet \_\_\_\_\_ meters ☐ above or ☐ below the HAG.E3. Attached garage (top of slab) is \_\_\_\_\_ feet \_\_\_\_\_ meters ☐ above or ☐ below the HAG.E4. Top of platform of machinery and/or equipment servicing the building is \_\_\_\_\_ feet \_\_\_\_\_ meters ☐ above or ☐ below the HAG.E5. Zone AO only: If no flood depth number is available, is the top of the bottom floor elevated in accordance with the community's floodplain management ordinance? ☐ Yes ☐ No ☐ Unknown. The local official must certify this information in Section G.**SECTION F - PROPERTY OWNER (OR OWNER'S REPRESENTATIVE) CERTIFICATION**

The property owner or owner's authorized representative who completes Sections A, B, and E for Zone A (without a FEMA-issued or community-issued BFE) or Zone AO must sign here. The statements in Sections A, B, and E are correct to the best of my knowledge.

Property Owner's or Owner's Authorized Representative's Name

Address

City

State

ZIP Code

Signature

Date

Telephone

Comments

☐ Check here if attachments**SECTION G - COMMUNITY INFORMATION (OPTIONAL)**

The local official who is authorized by law or ordinance to administer the community's floodplain management ordinance can complete Sections A, B, C (or E), and G of this Elevation Certificate. Complete the applicable item(s) and sign below. Check the measurement used in Items G8. and G9.

G1. ☐ The information in Section C was taken from other documentation that has been signed and sealed by a licensed surveyor, engineer, or architect who is authorized by law to certify elevation information. (Indicate the source and date of the elevation data in the Comments area below.)G2. ☐ A community official completed Section E for a building located in Zone A (without a FEMA-issued or community-issued BFE) or Zone AO.G3. ☐ The following information (Items G4.-G9.) is provided for community floodplain management purposes.

G4. Permit Number

G5. Date Permit Issued

G6. Date Certificate Of Compliance/Occupancy Issued

G7. This permit has been issued for: ☐ New Construction ☐ Substantial Improvement

G8. Elevation of as-built lowest floor (including basement) of the building: \_\_\_\_\_ feet \_\_\_\_\_ meters (PR) Datum \_\_\_\_\_

G9. BFE or (in Zone AO) depth of flooding at the building site: \_\_\_\_\_ feet \_\_\_\_\_ meters (PR) Datum \_\_\_\_\_

Local Official's Name

Title

Community Name

Telephone

Signature

Date

Comments

☐ Check here if attachments