


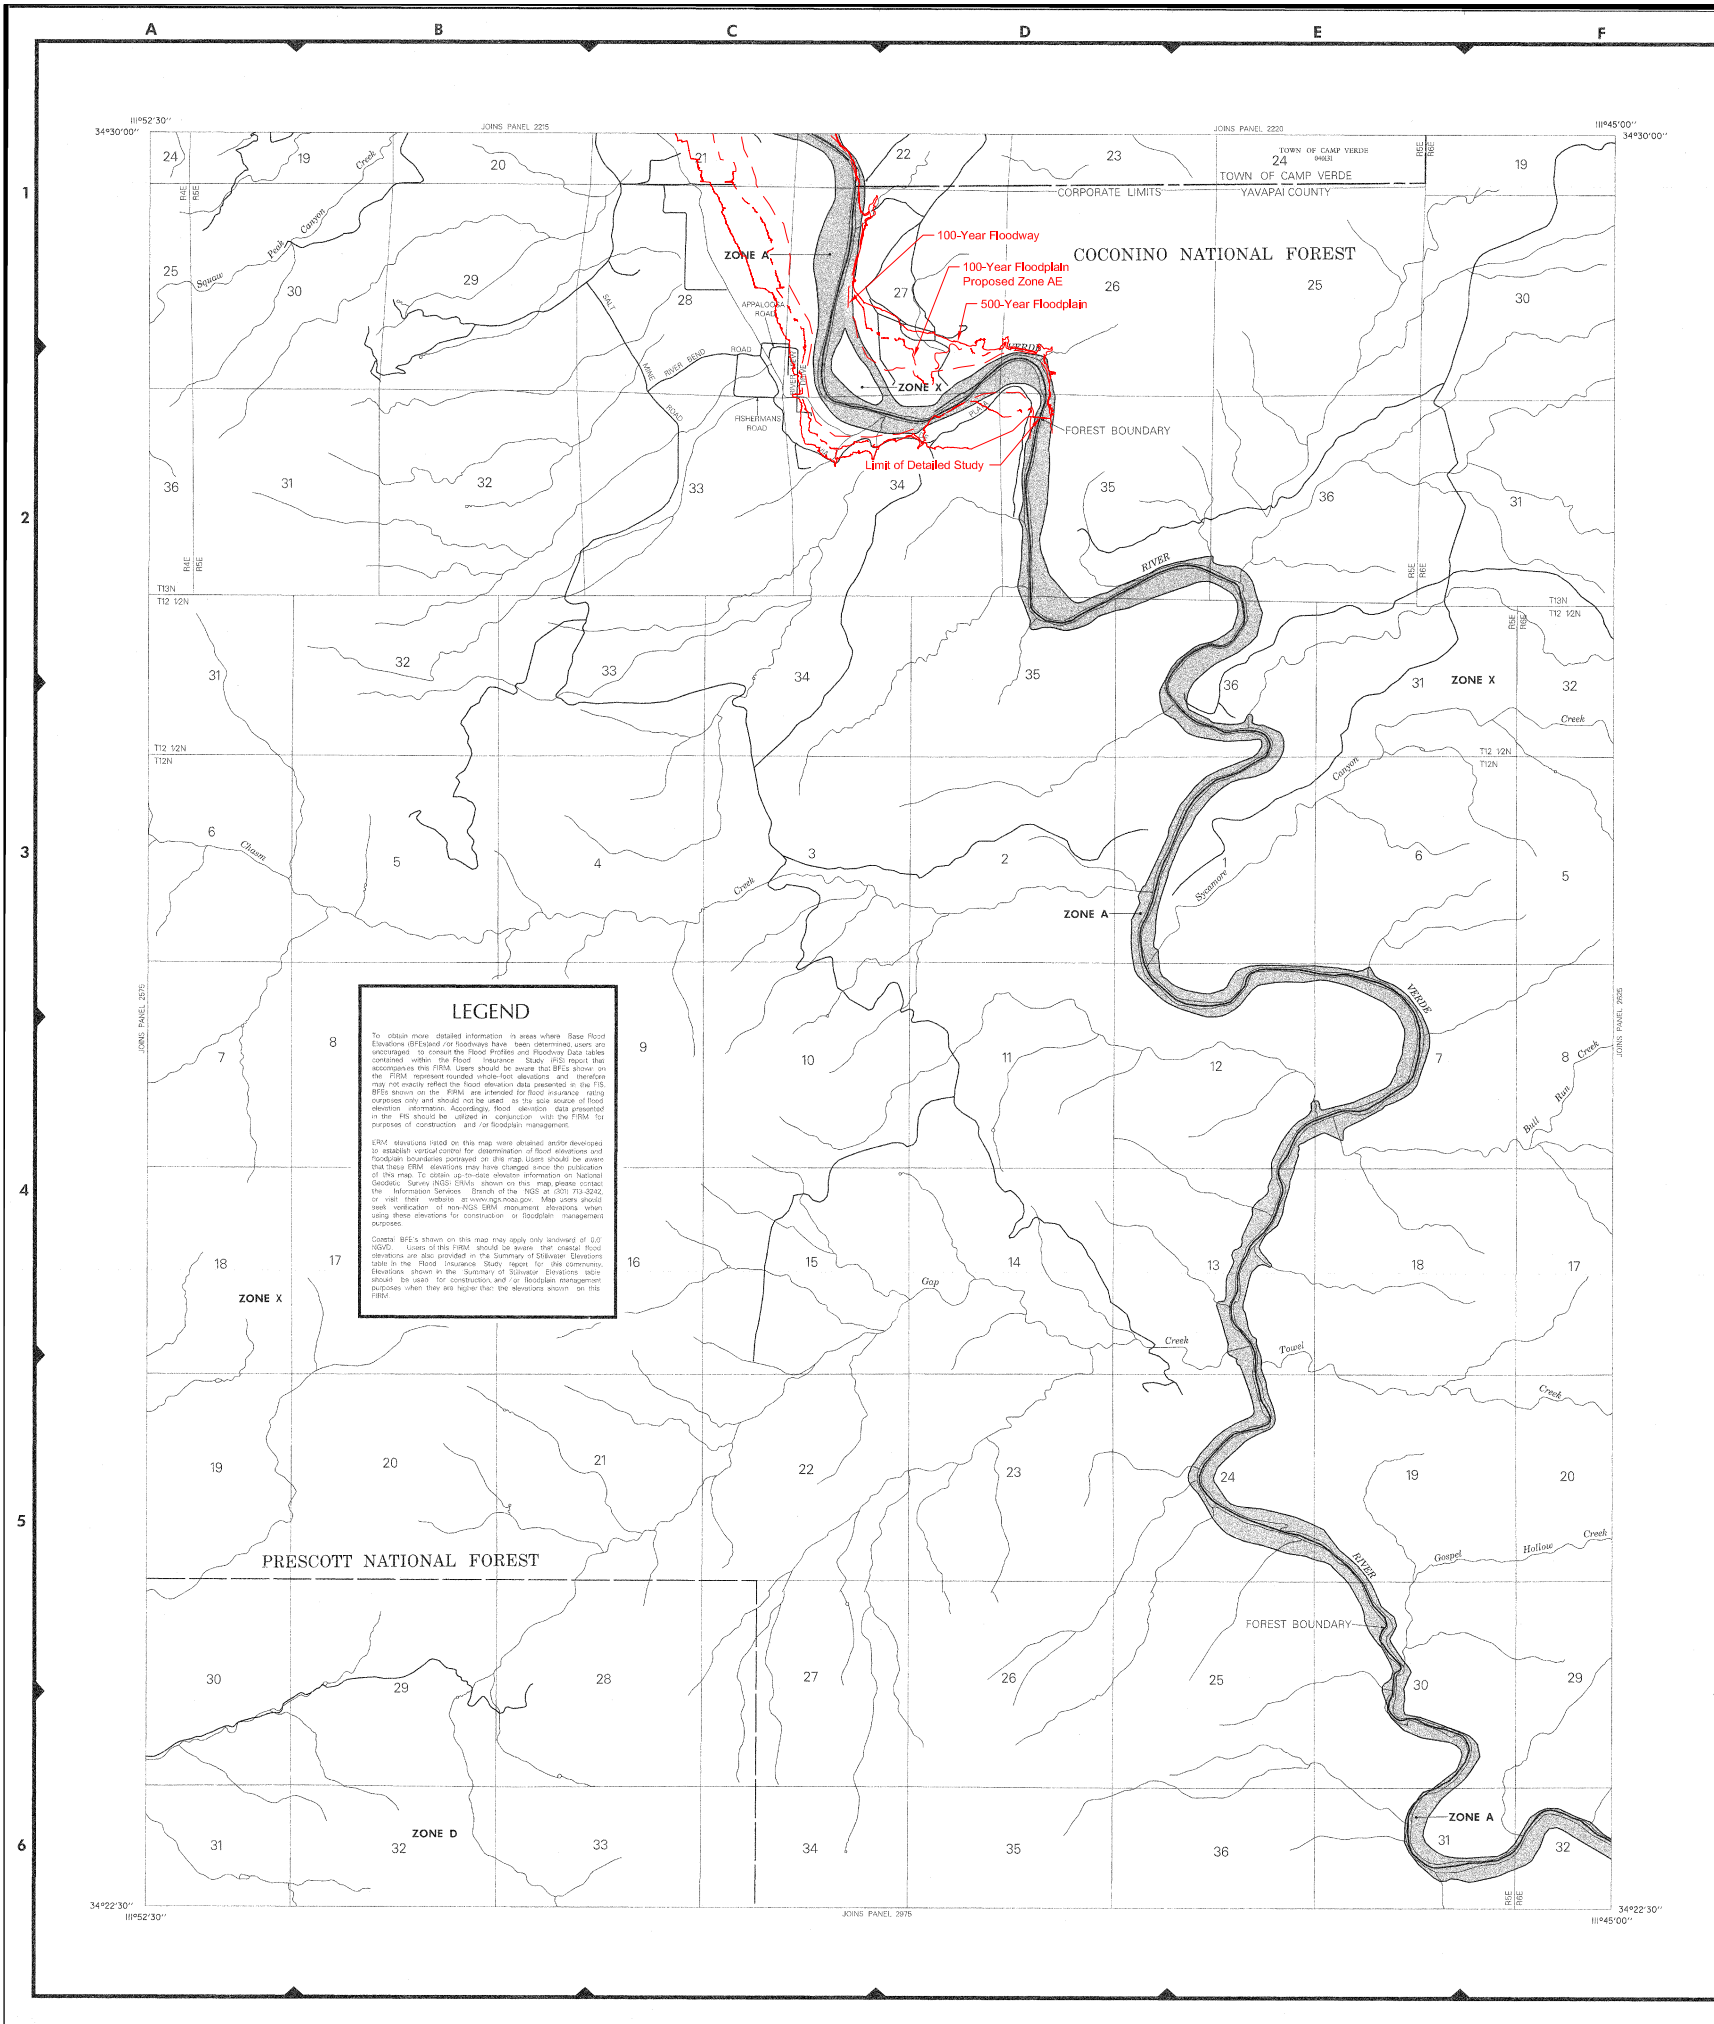

LEGEND

SPECIAL FLOOD HAZARD AREAS INUNDATED BY 100-YEAR FLOOD

ZONE A
No base flood elevations determined.

ZONE AE
Base flood elevations determined.

ZONE AH
Flood depths of 1 to 3 feet usually occur from an adjacent water body; base flood elevations determined.

ZONE AO
Flood depths of 1 to 3 feet usually occur from an adjacent water body; average depths determined; for areas of shallow (in flooding) elevation also determined.

ZONE APP
To be protected from 100-year flood by Federal flood protection system under construction; no base flood elevations determined.

ZONE V
Coastal flood with velocity hazard; wave action; no base flood elevations determined.

ZONE VE
Coastal flood with velocity hazard; wave action; base flood elevations determined.

FLOODWAY AREAS IN ZONE AE

OTHER FLOOD AREAS

ZONE X
Areas of 500-year flood; areas of 100-year flood with average depths of less than 1 foot or with drainage areas less than 1 square mile; and areas protected by levees from 100-year flood.

OTHER AREAS

ZONE X
Areas determined to be outside 500-year floodway.

ZONE D
Areas in which flood hazards are undetermined.

UNDEVELOPED COASTAL BARRIERS

Identified
Coastal barrier areas are normally located within or adjacent to Special Flood Hazard Areas.

Identified
Flooded

Observed
Protected Areas

Floodway Boundary
Floodway Boundary
Zone D Boundary
Boundary Delineating Special Flood Hazard Zones, and Boundary Delineating Areas of Different Coastal Base Flood Elevations Within Special Flood Hazard Zones.
Base Flood Elevation Line
Elevation in Feet; See Map Index for Elevation Datum.
Cross Section Line
Base Flood Elevation in Feet
Where Uniform Within Zone
See Map Index for Elevation Datum.
Elevation Reference Mark
River Mile
National Coordinates Based on North American Datum of 1927 (NAD 27) Projection.

NOTES

This map is for use in administering the National Flood Insurance Program. It does not necessarily identify all areas subject to flooding, particularly from local drainage sources of small size, or all plantings. Features outside Special Flood Hazard Areas. The community map repository should be consulted for more detailed data on BFEs, and for any information on floodway determinations, prior to use of this map for property purchase or construction purposes.

Areas of Special Flood Hazard (100-year flood) include Zones A, AE, AH, AO, APP, V, VE, and X.

Certain areas not in Special Flood Hazard Areas may be protected by flood control structures.

Boundaries of the floodways were computed at cross sections and interpolated between cross sections. The floodways were based on hydraulic considerations with regard to requirements of the Federal Emergency Management Agency.

Floodway widths in some areas may be too narrow to show in scale. Refer to Floodway Data Tables when floodway width is shown at 1/2 inch.

Corporate limits shown are current as of the date of this map. The user should contact appropriate community officials to determine if corporate limits have changed subsequent to the issuance of this map.

This map may incorporate approximate boundaries of Coastal Barrier Resource System Units and for Otherwise Protected Areas established under the Coastal Barrier Improvement Act of 1980 (P.L. 96-380).

For community-wide floodway history prior to nationwide mapping, see Section 6.0 of the Flood Insurance Study Report.

For adjoining map panels and base map source see separately printed Map Index.

MAP REPOSITORY
Refer to Repository Listing on Map Index.

**EFFECTIVE DATE OF
COUNTY-WIDE FLOOD INSURANCE RATE MAP:
JUNE 6, 2001**

EFFECTIVE DATE(S) OF REVISION(S) TO THIS PANEL:

Refer to the FLOOD INSURANCE RATE MAP EFFECTIVE DATE shown on this map to determine when actuarial rates apply to structures in zones where elevations or depths have been established.

To determine if flood insurance is available contact an insurance agent or call the National Flood Insurance Program at (800) 638-6620.

100-Year Floodway
100-Year Floodplain
500-Year Floodplain
Floodway Line

APPROXIMATE SCALE IN FEET
0 2000
2000

NATIONAL FLOOD INSURANCE PROGRAM

**FIRM
FLOOD INSURANCE RATE MAP**

**YAVAPAI COUNTY,
ARIZONA AND
INCORPORATED AREAS**

PANEL 2600 OF 3925
(SEE MAP INDEX FOR PANELS NOT PRINTED)

CONTAINS COMMUNITY	NUMBER	PANEL	SUFFIX
CAMP VERDE, TOWN OF	04025C	2600	F
YAVAPAI COUNTY UNINCORPORATED AREAS	04025C	2600	F

**MAP NUMBER
04025C2600 F**

**EFFECTIVE DATE:
JUNE 6, 2001**


Federal Emergency Management Agency