

HDR - VERDE RIVER - MINGUS BRIDGE (Top of Bridge)
SWI PROJECT #09114

POINT #	NORTHING	EASTING	ELEVATION
200324011	1360368.24	674718.60	3291.33
200324012	1360385.18	674719.34	3291.70
200324013	1360402.12	674720.34	3291.39
200324014	1360353.83	675720.78	3294.48
200324015	1360336.78	675719.94	3293.83
200324016	1360320.00	675719.14	3293.23



Expires 9/30/2012

HDR - VERDE RIVER - MINGUS BRIDGE (Ground Shots) Page 1 of 2
SWI PROJECT #09114

POINT #	NORTHING	EASTING	ELEVATION
200324001	1360429.15	674743.28	3267.12
200324002	1360434.42	674734.90	3268.77
200324003	1360417.34	674726.14	3279.31
200324004	1360413.16	674731.39	3279.49
200324005	1360356.43	674719.19	3279.87
200324006	1360359.27	674724.95	3279.74
200324007	1360363.87	674729.19	3280.43
200324008	1360339.49	674726.69	3269.60
200324009	1360343.19	674738.34	3267.50
200324010	1360351.13	674745.78	3267.28
200324017	1360302.91	675672.38	3271.35
200324018	1360304.26	675683.28	3276.80
200324019	1360309.91	675697.49	3282.38
200324020	1360314.21	675690.32	3282.09
200324021	1360366.18	675692.40	3281.91
200324022	1360367.91	675696.49	3281.94
200324023	1360369.35	675700.69	3281.84
200324024	1360379.85	675694.48	3275.90
200324025	1360385.44	675687.21	3272.32
200325005	1360359.23	674749.86	3266.95
200325006	1360379.79	674751.70	3267.19
200325007	1360401.32	674752.26	3267.33
200325008	1360413.18	674751.79	3267.44
200325009	1360424.97	674746.31	3268.15
200325010	1360428.09	674736.49	3272.84
200325011	1360419.40	674746.47	3272.51
200325012	1360402.83	674748.39	3272.19
200325013	1360383.31	674747.45	3272.48
200325014	1360366.09	674746.97	3272.24
200325015	1360352.58	674741.52	3272.50
200325016	1360343.45	674732.22	3272.03
200325017	1360341.57	674729.30	3271.90
200325018	1360376.60	674730.53	3279.62
200325019	1360388.83	674730.63	3279.51
200325020	1360399.78	674731.44	3279.27
200325021	1360407.65	674732.10	3279.22
200325022	1360408.39	674724.40	3279.76
200325023	1360396.75	674723.36	3279.97
200325024	1360375.89	674722.19	3280.04
200325025	1360364.81	674722.20	3279.99
200325026	1360315.59	675689.79	3282.13
200325027	1360344.55	675690.20	3282.03
200325028	1360356.24	675690.70	3281.96
200325029	1360364.20	675691.01	3281.97
200325030	1360377.30	675677.46	3273.19
200325031	1360367.18	675671.67	3273.09
200325032	1360347.92	675670.40	3273.30
200325033	1360327.27	675669.94	3273.86


HDR - VERDE RIVER - MINGUS BRIDGE (Ground Shots) Page 2 of 2
SWI PROJECT #09114

200325034	1360312.64	675670.77	3274.22
200325035	1360306.27	675672.87	3274.01
200325036	1360313.31	675667.04	3268.19
200325037	1360333.71	675666.30	3267.36
200325038	1360358.49	675668.04	3268.22
200325039	1360370.98	675669.99	3268.12
200325040	1360376.83	675673.07	3269.36

SHEPHARD - WESNITZER, INC.
consulting engineers
P.O. Box 3924 • Sedona, AZ 86340

Job No.	09114
Date	03-25-10
By	K. CLAWSON
Sheet No.	1 OF 2

Subject **MINGUS AVE BRIDGE**

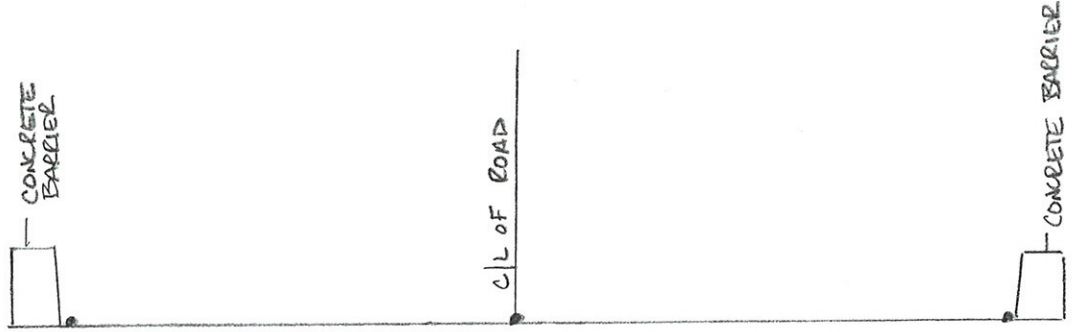

METAL JUNCTION

TOOK SHOTS
ON TOP AND TOE
OF ROCK BARRIER NORTH



Expires 9/30/2012

← RIVER FLOW

DOTS ARE THE SHOTS
TAKEN ON TOP OF BRIDGE

NORTH

