

PAT

ARIZONA LAND SURVEY CORNER RECORD

MONUMENT FIELD VISIT INFORMATION

INDEX CODE

DATE OF FIELD VISIT NOV 11, 2008 MONUMENT ACCEPTED AS MARKING CORNER LOCATION:

- LEFT AS FOUND
- FOUND & TAGGED
- FOUND & REBUILT
- RESTORED LOST CORNER
- RESTORED OBLITERATED CORNER
- ESTABLISHED NEW ACCESSORIES

GLO/BLM NOTES REC. & REF. _____

ARIZONA STATE PLANE COORDINATE SYSTEM: ESTABLISHED TO _____ ORDER, CLASS _____

ZONE: WEST CENTRAL EAST QUADRANGLE DESIGNATION # _____

N.A.D. 1927 (FEET) N.A.D. 1983 (METERS) W.G.S. 1984 (METERS)

N.A.V.D. 1929 (FEET) N.A.V.D. 1988 (METERS) GEOD HEIGHT _____

N. (OR) Y = _____ E. (OR) X = _____ ELEVATION 3104.22 NGVD 29 DATUM

LATITUDE N34°34'02.84" LONGITUDE W111°51'16.72" GRID FACTOR 3106.56 NAVD 88 DATUM

CONTROL STATIONS USED: RM 112


DESCRIBE ALL EVIDENCE FOUND, INCLUDING TIES AND ACCESSORIES TO COMPLY WITH ARIZONA REVISED STATUTE TITLE 33, SECTION 106: _____

RM 119A - SET 2" DIAMETER Y.C.F.C.D. ALUMINUM CAP IN A CONCRETE BASE
ON THE WEST SIDE OF MONTEZUMA CASTLE HIGHWAY NORTH OF THE VERDE DITCH
CONCRETE IRRIGATION CULVERT. THIS RM REPLACES RM 118 (DESTROYED)
& RM 119 (TRUE LOCATION NOT DETERMINED). [RM 119 WAS RM 1095-1]

RM 119A ELEVATION = 3104.22 NGVD 29 DATUM PER LEVEL BENCH CIRCUIT*
3106.56 NAVD 88 DATUM PER VERTCON CONVERSION
NAVD 88 (AS SHOT BY SHEPARD-WESNITZER) = 3106.72

*LEVEL BENCH CIRCUIT FROM RM 112 TO RM 119A

CORNER MONUMENT CAP STAMPING

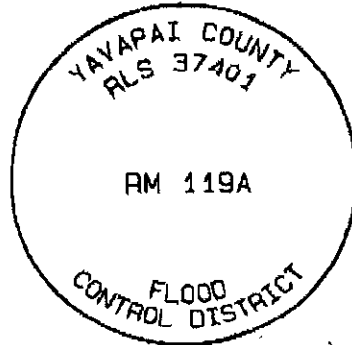

CORNER LOCATION INFORMATION

TOWNSHIP 14 NORTH RANGE 5 EAST

SECTION 31 CORNER INDEX CODE W-5

G&SRB& MERIDIAN YAVAPAI COUNTY

FORMAL CORNER NAME: RM 119A

- ALIQUOT GOV'T COR.
- NON-ALIQUOT GOV'T COR.
- OTHER