


35

CAMP VERDE

# 09114  
CAMP VERDE

31

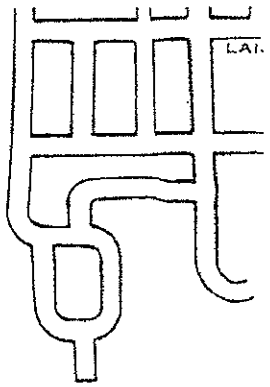

Lower Camp Ve  
Indiar Reservat  
AREA LOT INCLU

R4E  
R5E

T14N  
T13N

ZONE B

Creek

RM130A  
 SET YCFCD ALUM CAP  
 FLUSH W/ PAVEMENT  
 ELEVATION = 3057.97  
 NAVD88 = 3060.15

ZONE A

LIMIT OF  
DETAILED  
STUDY

ZONE B

VERDE

ZONE A17

Ditch

SPRUCE  
STREET

FORT APACHI  
FORT  
MCDOWELL  
PLACE

Lucky Canyon  
Creek

12

Hoods

PEARL DRIVE

PINE ST

ELM ST

FIR ST

RM130

HILL D

WAL

