


SHEPHARD - WESNITZER, INC.

consulting engineers


P.O. Box 3924 • Sedona, AZ 86340

Job No.	69114
Date	03-12-16
By	K. CLAWSON
Sheet No.	3 OF 3

Subject VERDE RIVER - I-17 SOUTHBOUND BRIDGE

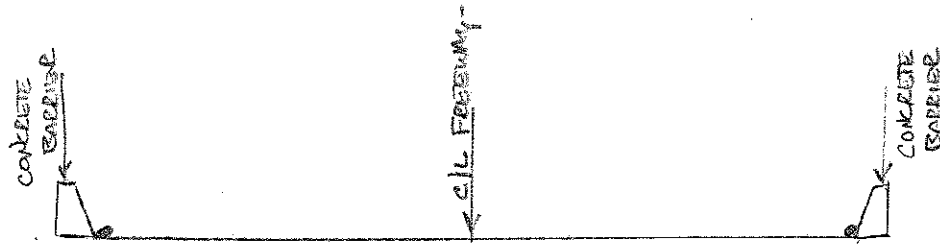

SHOTS ARE TAKEN AT BOTTOM OF BARRIER ON BOTH SIDES.

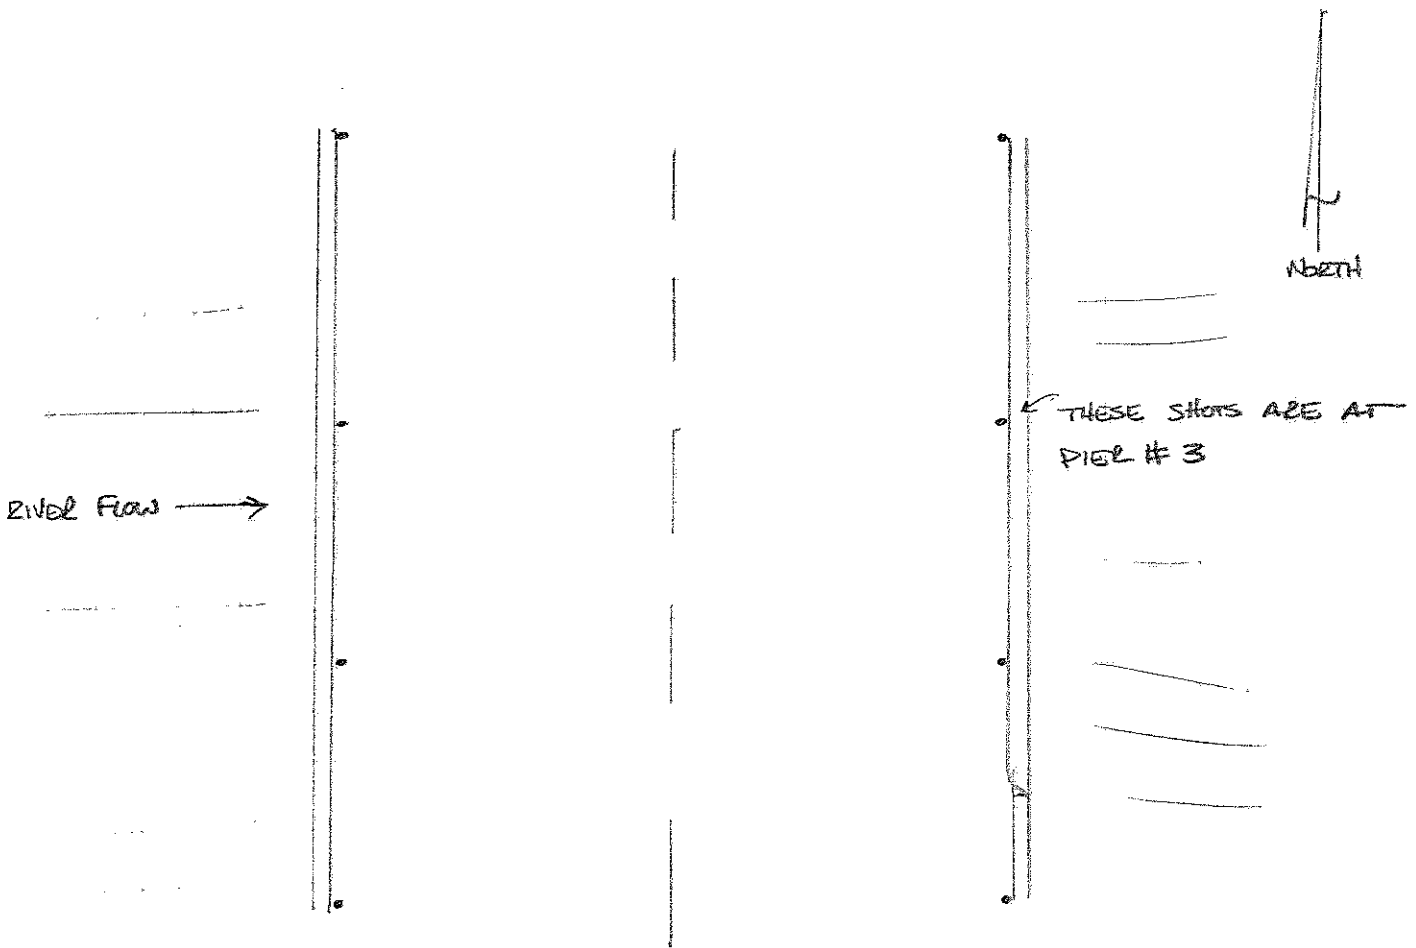

SHOTS ARE TAKEN AT METAL JOINT ON NORTH AND SOUTH SIDE OF FREEWAY BRIDGE - TOOK SHOTS AT PIER 3.

**HDR - VERDE RIVER - I-17 SOUTHBOUND BRIDGE (Top of Bridge)
SWI PROJECT #09114**

POINT #	NORTHING	EASTING	ELEVATION
200212015	1305208.87	711257.37	3115.43
200212016	1305007.84	711169.06	3115.73
200212017	1304859.01	711103.69	3115.72
200212018	1304731.29	711047.39	3115.49
200212019	1304700.45	711079.67	3115.55
200212020	1304841.46	711141.52	3115.81
200212021	1304990.46	711207.10	3115.84
200212022	1305178.11	711289.44	3115.57